


T.14S.R.4W.W.M.

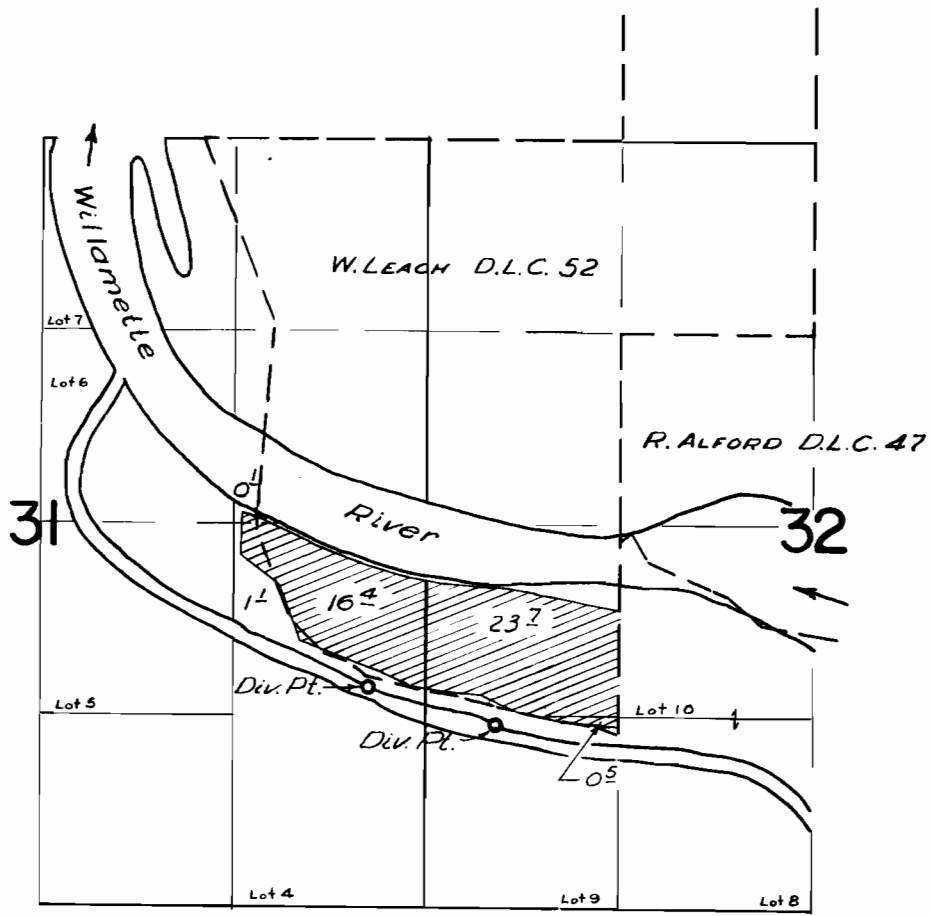

**FINAL PROOF SURVEY**  
UNDER

Application No. 32442 Permit No. 25609  
IN NAME OF

VICTOR J. HAFFNER

Surveyed 29 July 1960, by Tr. B. Bish