


T.24S. R.39E.W.M.

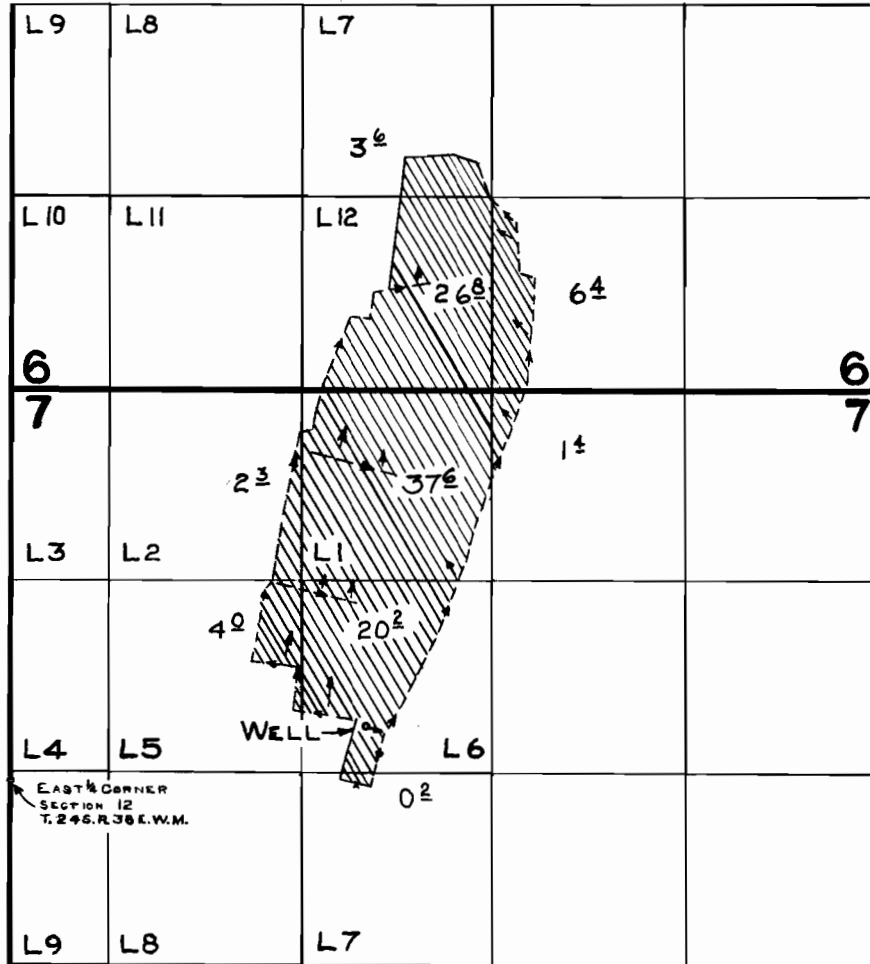

FINAL PROOF SURVEY UNDER

Application No. G.303 Permit No. G.324
IN NAME OF

BUDD ROGERS

Surveyed Nov. 3 1960, by M. BISH