


T. 33 S. R. 39 E. W.W.

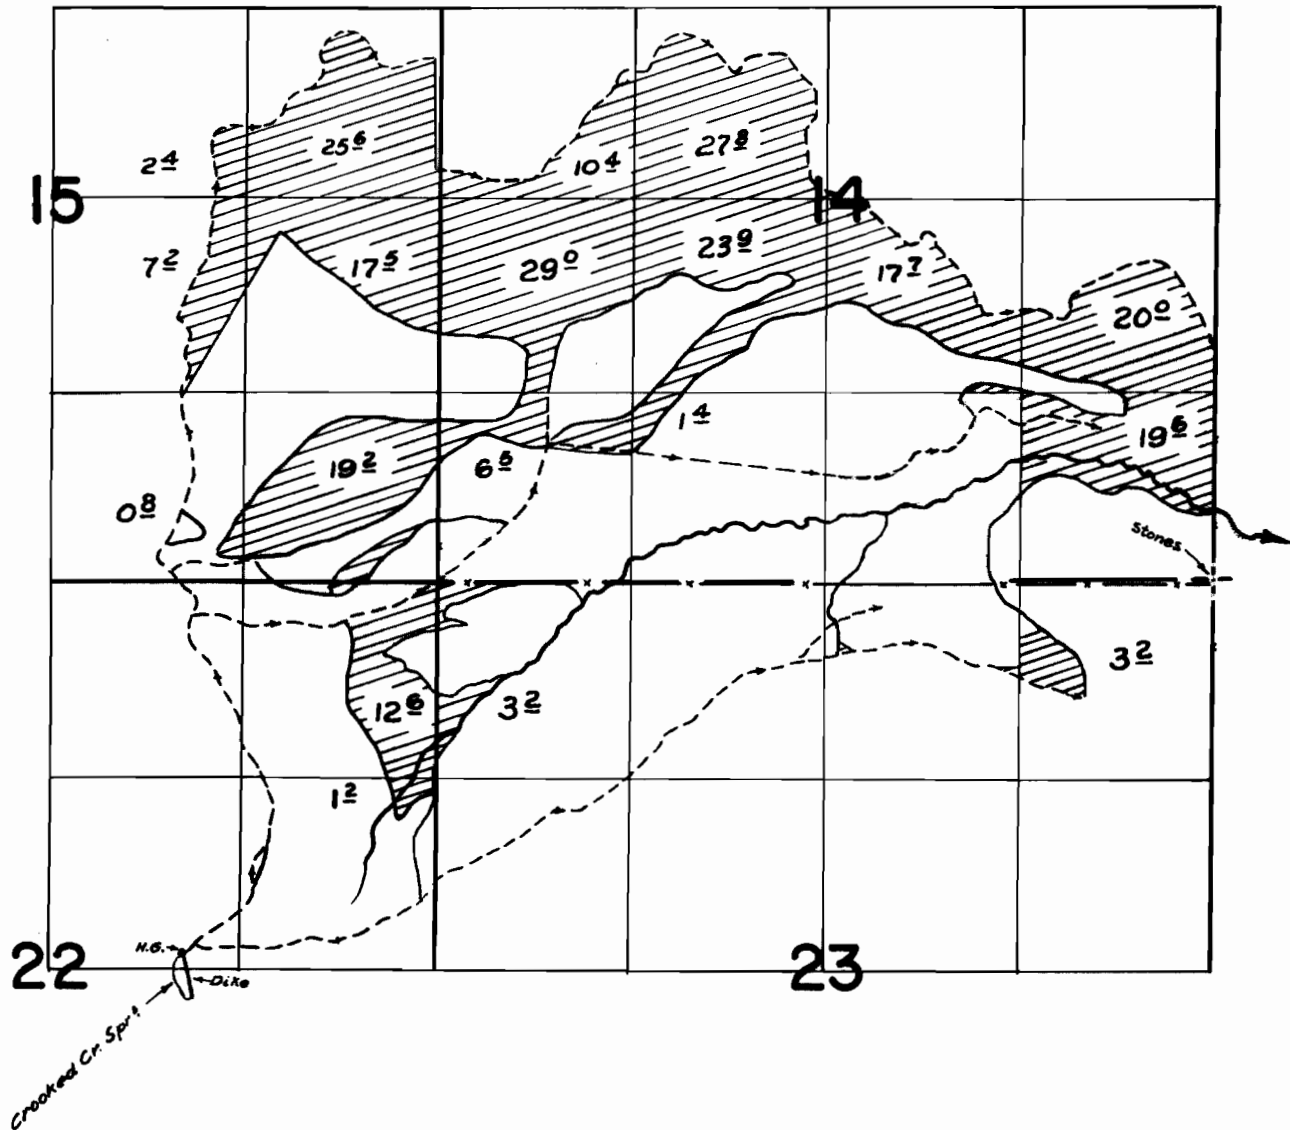

FINAL PROOF SURVEY
UNDER

Application No. 18181 Permit No. 43566
IN NAME OF

STODDART BROS.

Surveyed 25 Oct. 1960, by M. Rich