


T.20S.R.46E.W.M.

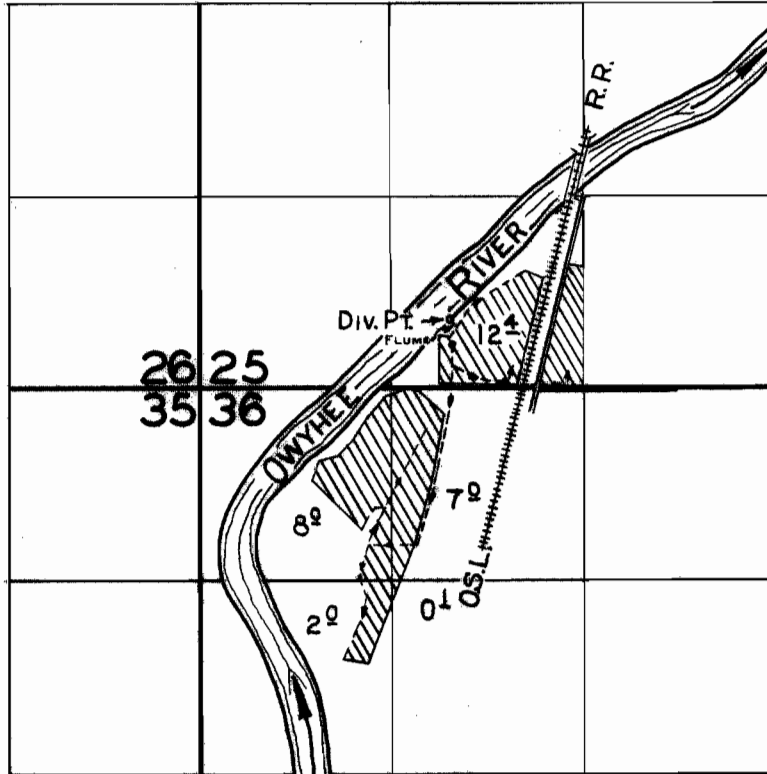

FINAL PROOF SURVEY UNDER

Application No. 21107 Permit No. 16540
IN NAME OF

ARCHIE D. MOSES

Surveyed Oct. 26, 1960, by M. BISH