


T.31S.R.41E.W.M.

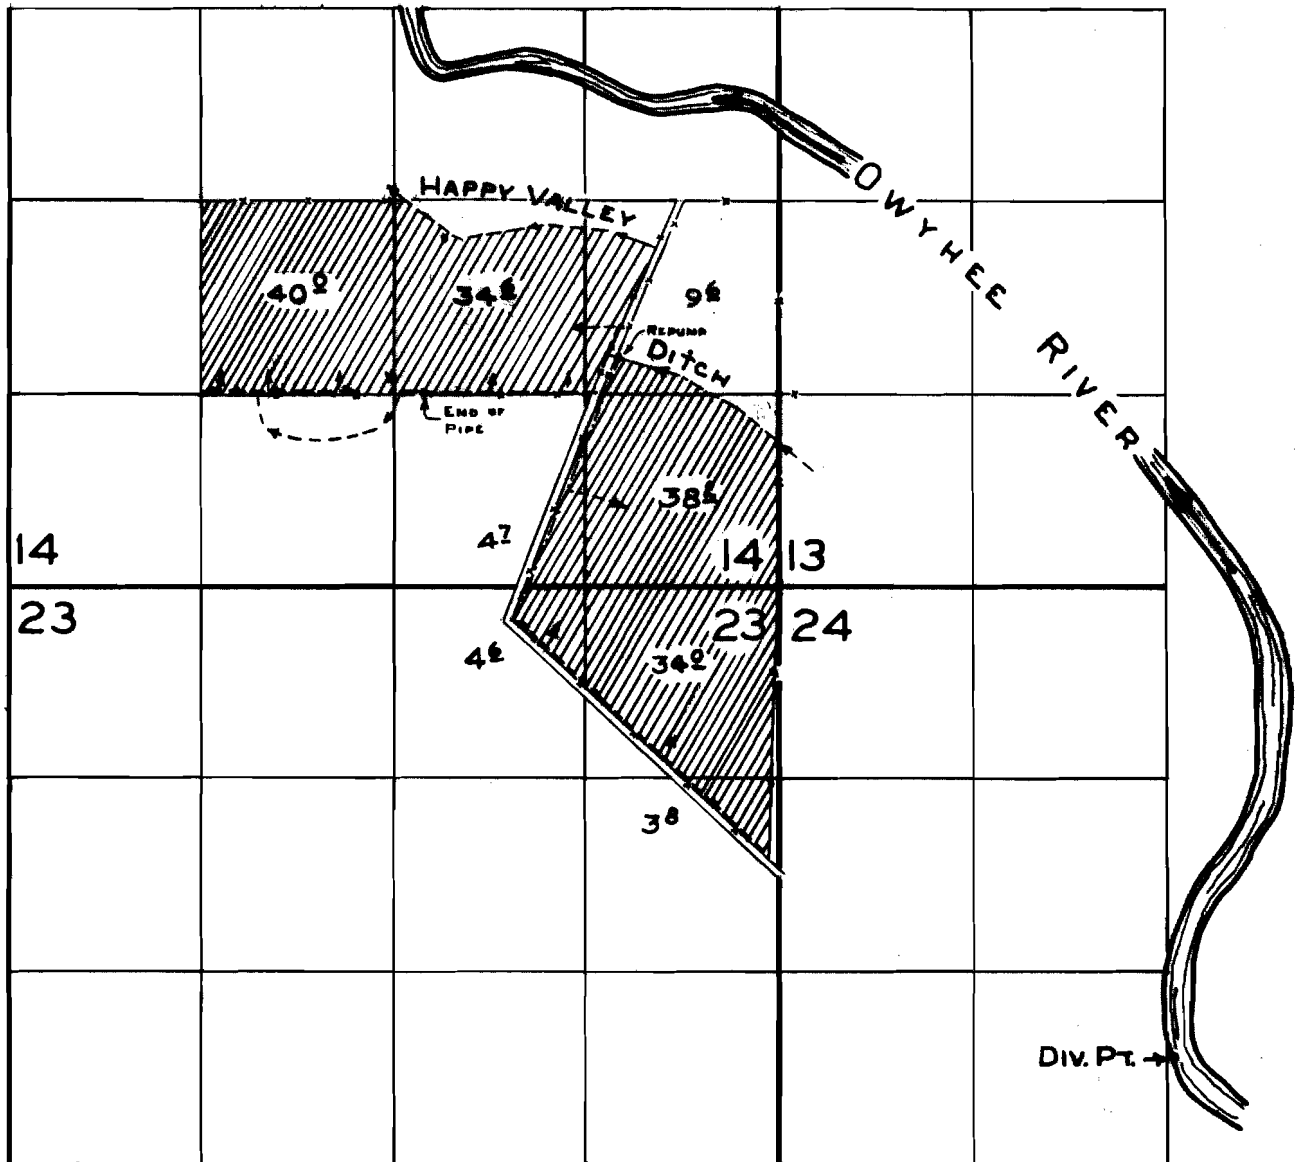

FINAL PROOF SURVEY
UNDER

Application No. 28673... Permit No. 23328..
IN NAME OF

.....MARVIN A. EASTERDAY.....

Surveyed Oct. 26 1960, by M. BISH.....