


T. 9S. R. 1E.W.M.

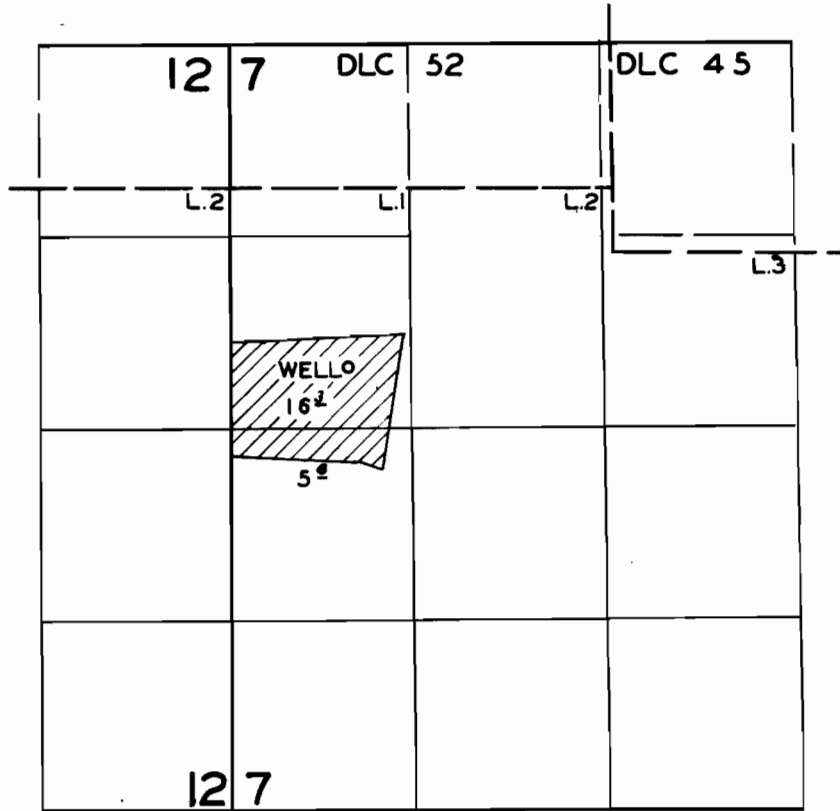

FINAL PROOF SURVEY UNDER

Application No. G 158 Permit No. G 81
IN NAME OF

JOHN L. APPLE

Surveyed JUNE 9 59 C. O. BARTELS
MARCH 28 19 60, by M. BISH