


T.7S. R. 1W. W.M.

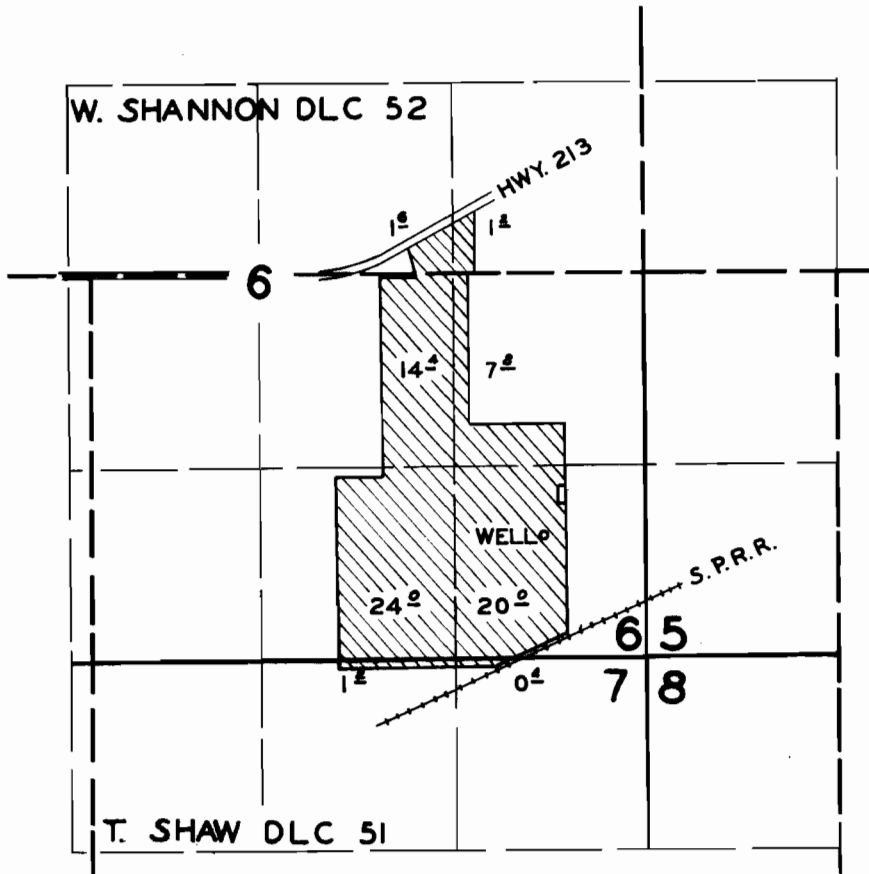

FINAL PROOF SURVEY UNDER

Application No. G.1221..... Permit No. G.967.....
IN NAME OF

.....**OLIVER E. STEFFEN**.....

Surveyed MAY 31 1960, by C.O. BARTELS