


T. 7S. R. 2W. W.M.

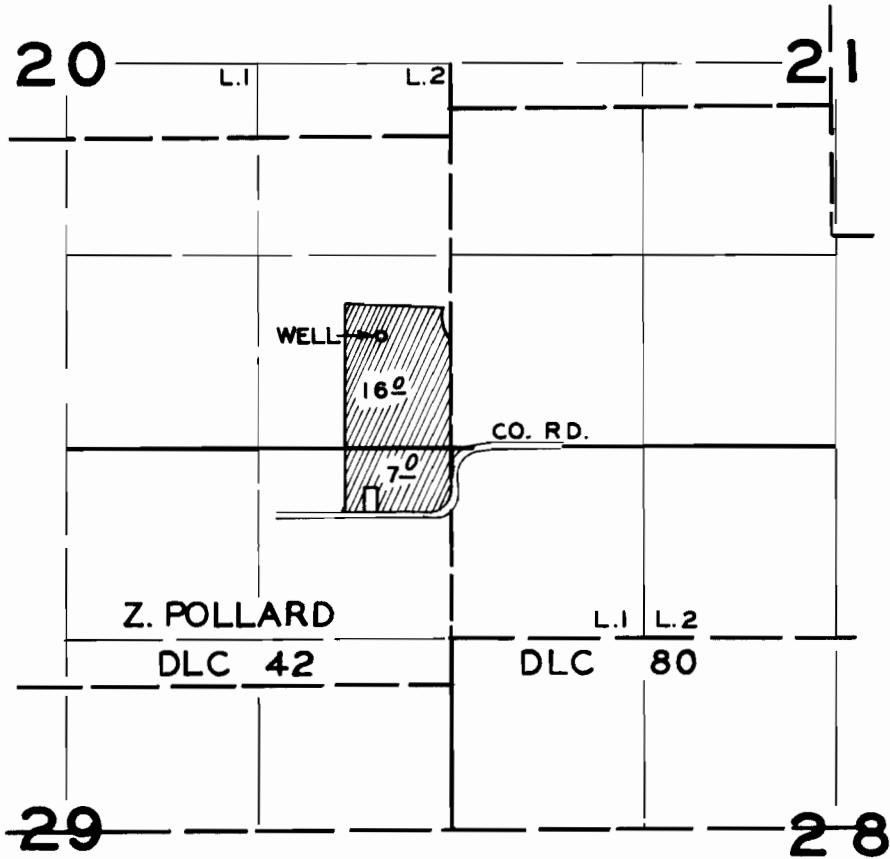

FINAL PROOF SURVEY  
UNDER

Application No. G 1251 Permit No. G1011  
IN NAME OF

ARNOLD W. MEYER

Surveyed MAY 16 1960, by

*[Handwritten signature]*