


T. 9S. R. 3E. W.M.

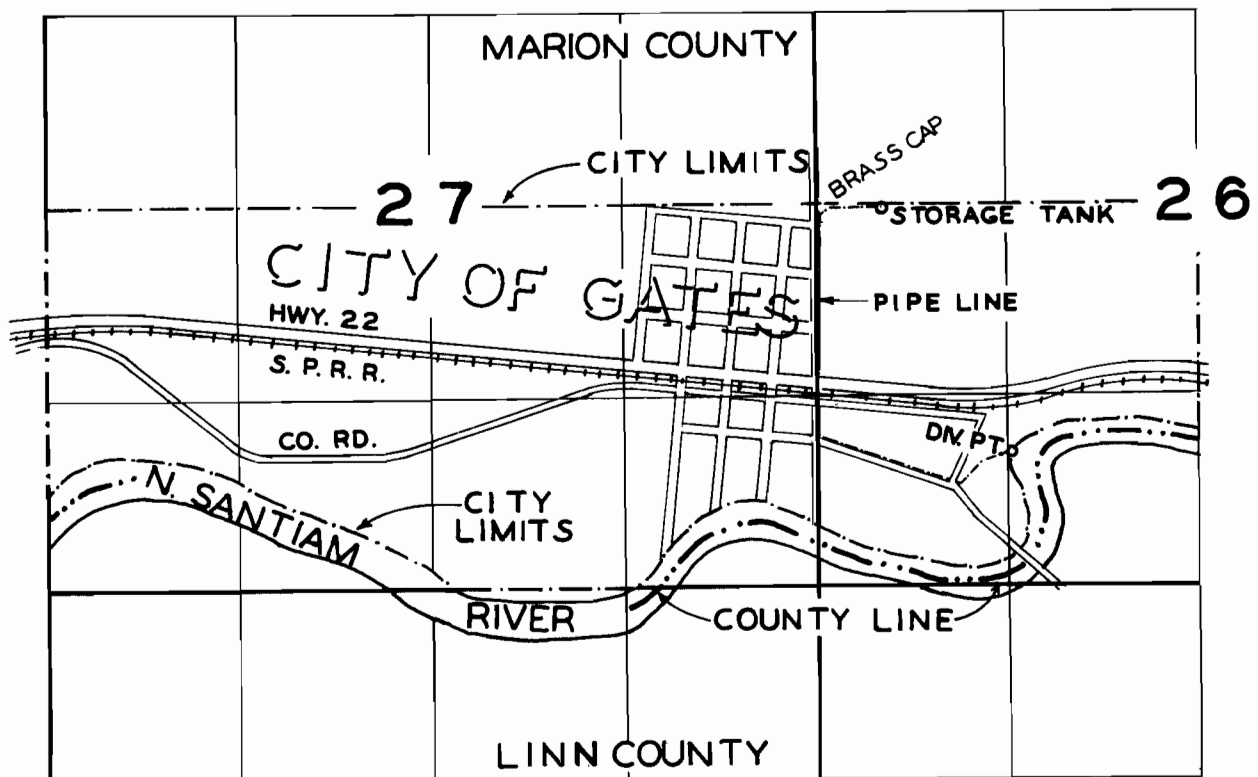

FINAL PROOF SURVEY
UNDER

Application No. 2 5573 Permit No. 20972
IN NAME OF

CITY OF GATES

Surveyed SEPT. 8 1960, by C.O. BARTELS

1960W *[Signature]*