


T. 6S. R. 1W. WM.

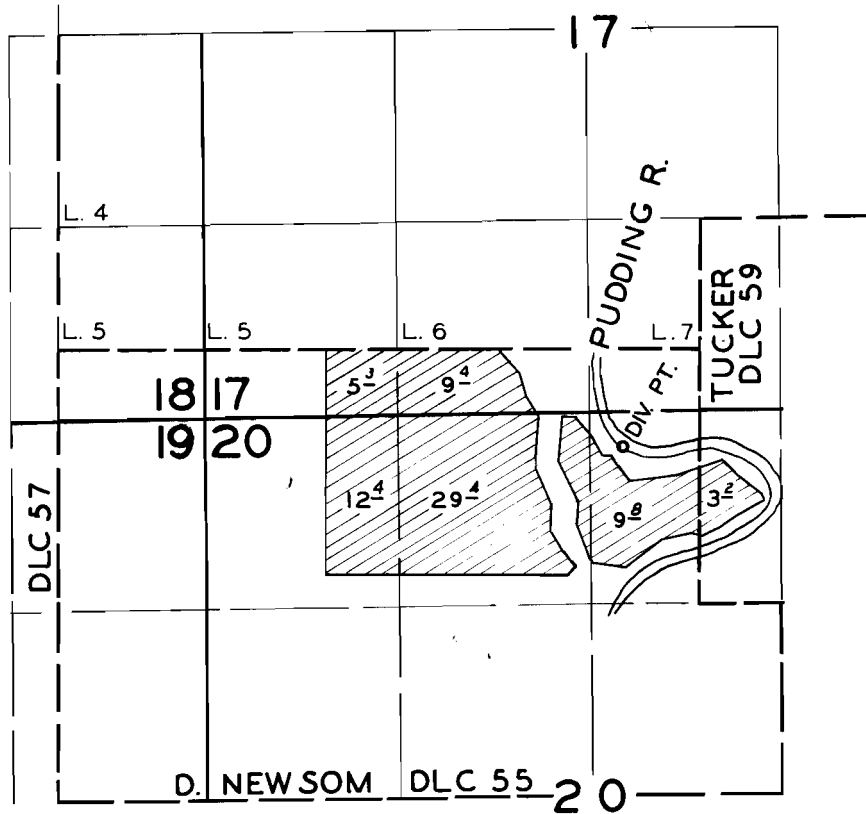

FINAL PROOF SURVEY UNDER

Application No. 27225..... Permit No. 21420.....
IN NAME OF

ANNA G. SIKA

Surveyed SEPT. 6, 1960, by C. O. BARTELS...