


T. 8 & 9 S. R. 3 E. W.M.

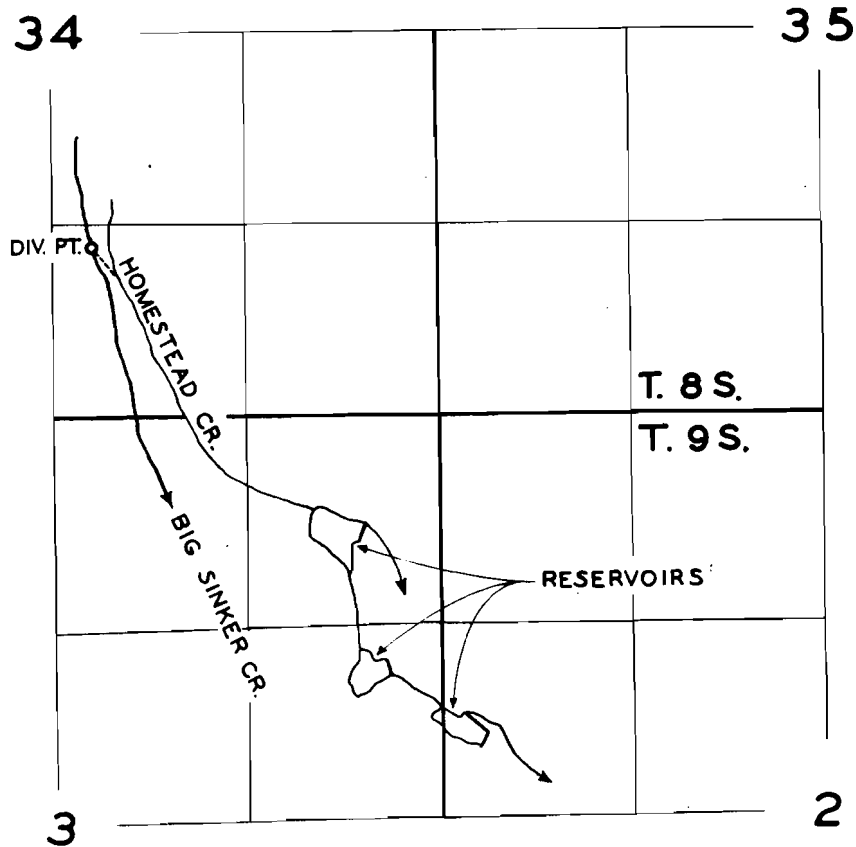

FINAL PROOF SURVEY UNDER

Application No. ²¹¹⁹⁰_{R30324} Permit No. ¹⁶⁶⁰⁷_{R1789} 23800
IN NAME OF

G. D. MYERS

Surveyed ^{MAY 5}_{JUNE 1} 19⁵⁵₆₀ by ^{T. JONES}_{C. O. BARTELS}