


T. 8S. R. 3W. W.M.

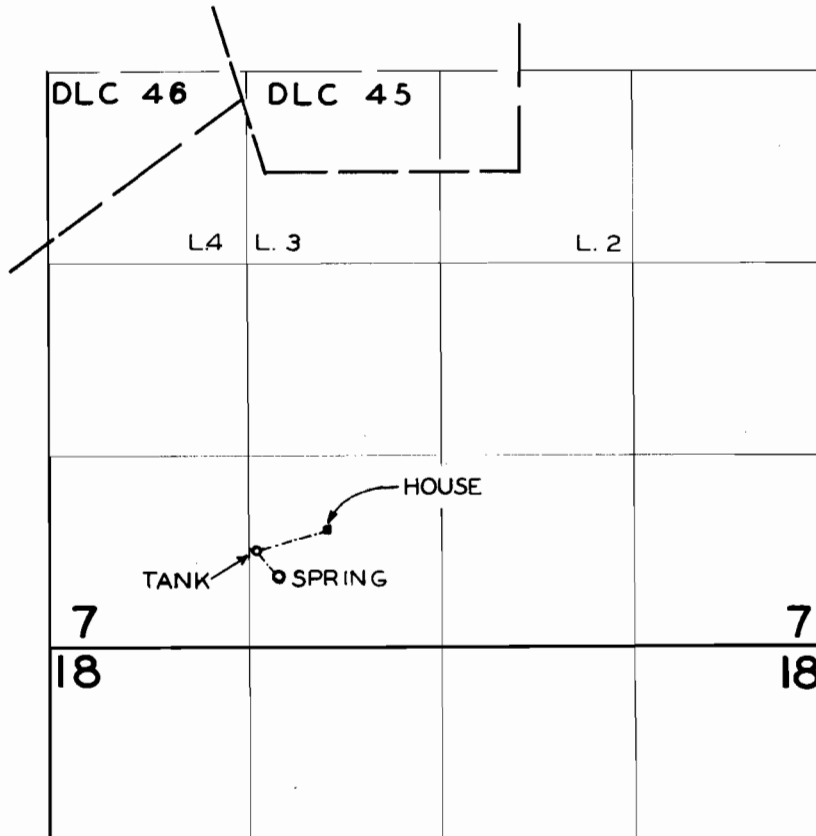

**FINAL PROOF SURVEY**  
UNDER

Application No. 31097 Permit No. 24469  
IN NAME OF

**WALTER WILLIAM, JR. & MARGURITE FELLMAN**

Surveyed SEPT. 9 1960, by C.O. BARTELS