


# T. 8 S. R. 3 W. W. M.

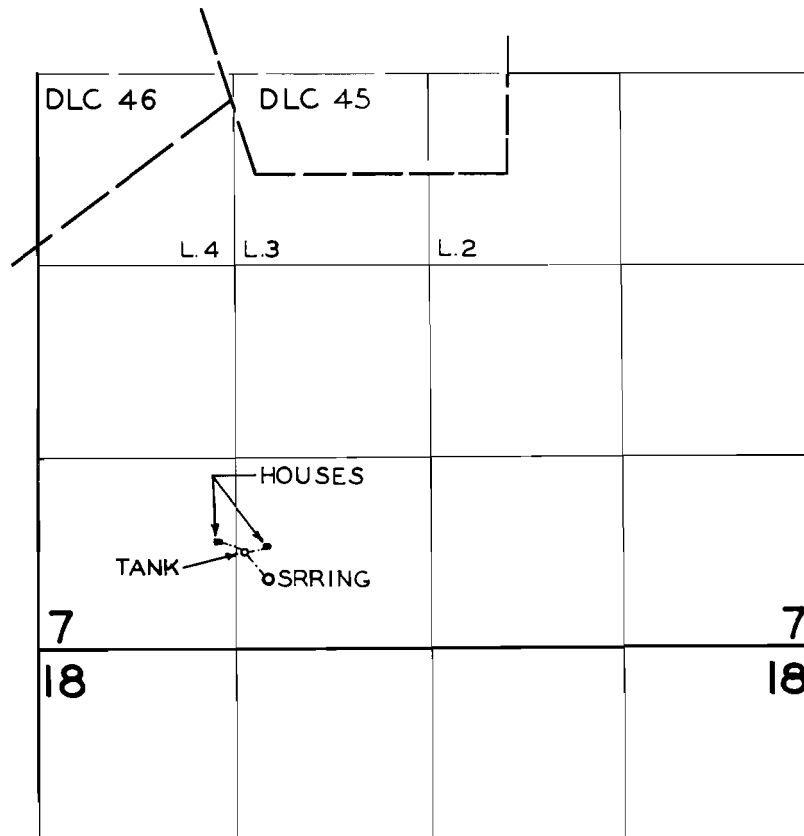

## FINAL PROOF SURVEY UNDER

Application No. 31098 Permit No. 24470  
IN NAME OF

WILFRED SYLVESTER

Surveyed SEPT. 9 1960, by C. O. BARTELS