


T. 5S. R. 1W. W.M.

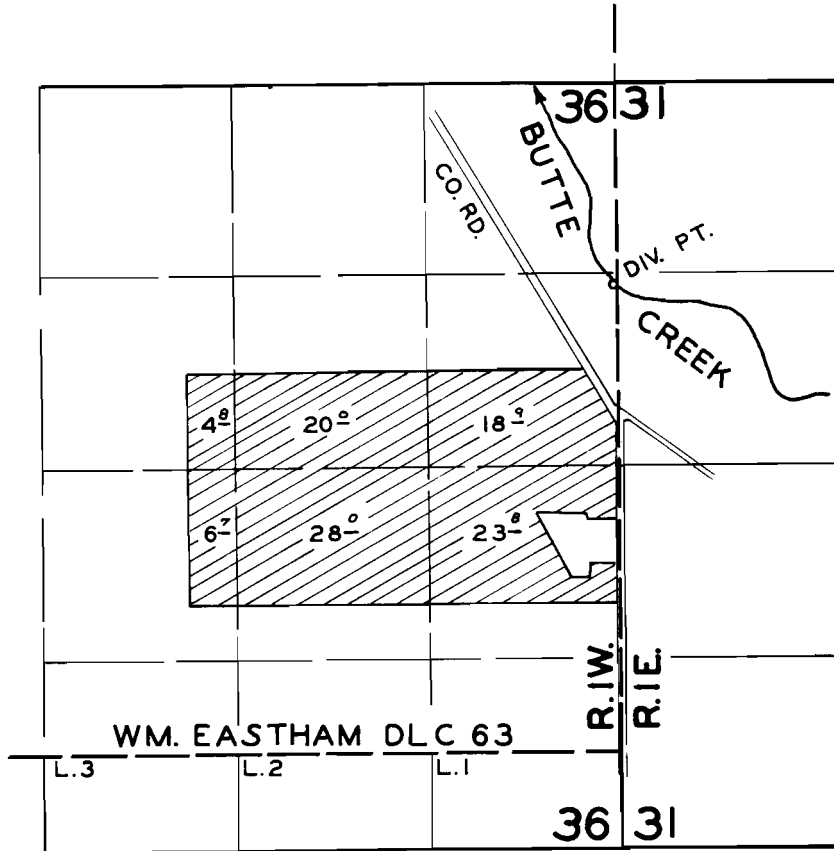

FINAL PROOF SURVEY
UNDER

Application No. 32232 Permit No. 25428
IN NAME OF

LOUIS BERNING

Surveyed JUNE 2 1960, by C. O. BARTELS