


T. 7S. R. 1W. W.M.

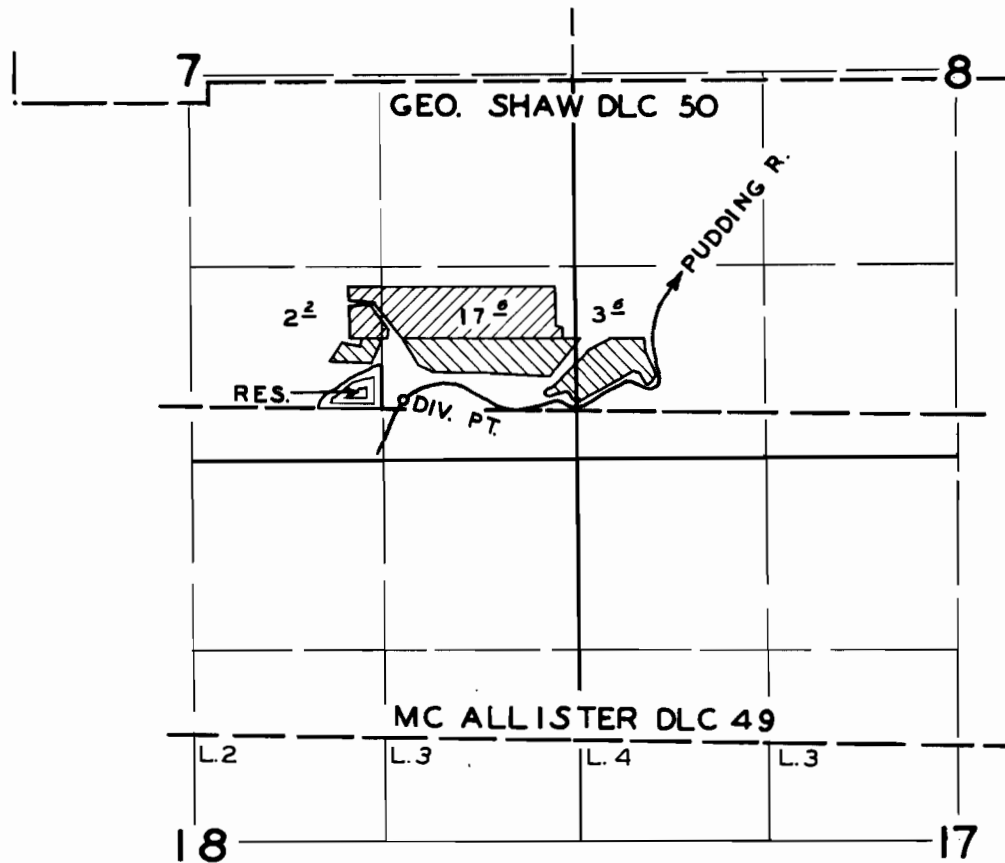

FINAL PROOF SURVEY UNDER

Application No. R33230 33231 Permit No. R2260 26268
IN NAME OF

ELDON S. ALT

Surveyed JUNE 2 1960, by C. O. BARTELS