


T. 7S. R. 4W. W.M.

SECTION 36

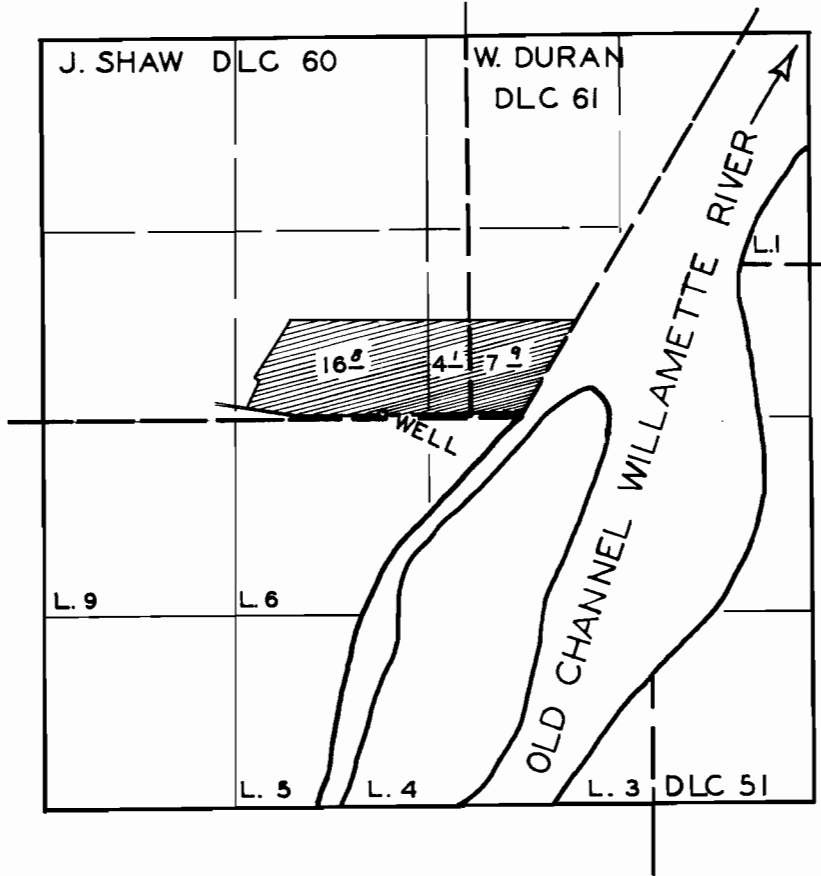

FINAL PROOF SURVEY  
UNDER

Application No. G 538 Permit No. G431  
IN NAME OF

GORDON DAGUE

Surveyed MAY 31 1960, by *[Signature]*