


T. 7S. R. 3W. W.M.

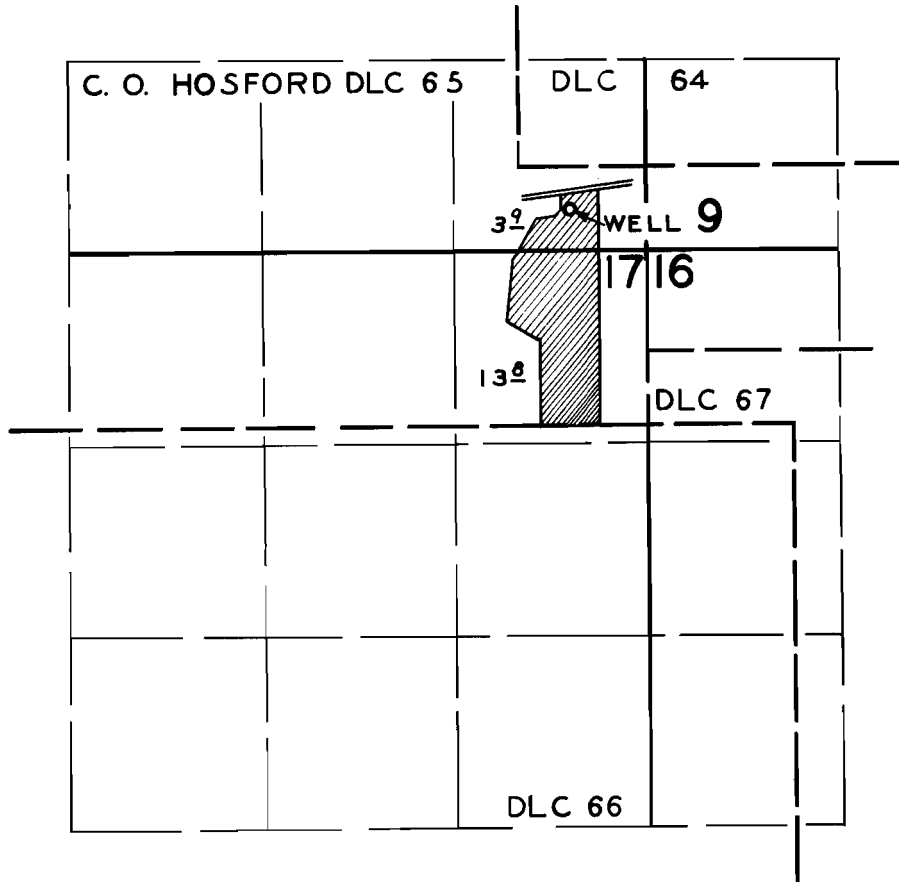

FINAL PROOF SURVEY
UNDER

Application No. G.519 Permit No. G.432
IN NAME OF

RALEIGH WORTHINGTON

Surveyed MAY 31 19.60, by