


T.8S.R.6W.W.M.

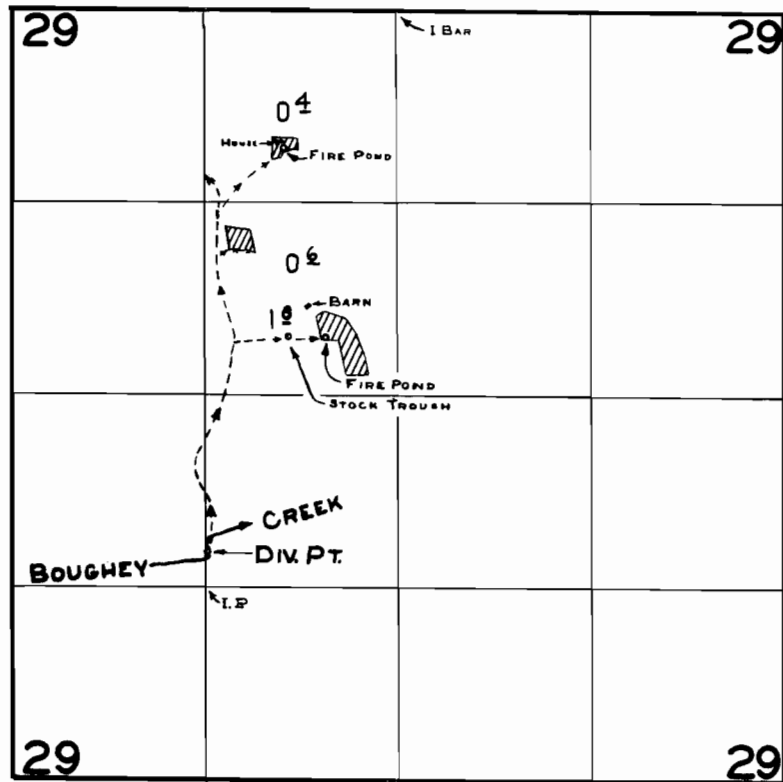

FINAL PROOF SURVEY
UNDER

Application No. 28497..... Permit No. 22500
IN NAME OF

WARD K., VERA A. & KATHERINE A. RICHARDSON

Surveyed SEPT. 7 & 8 1960, by M. BISH.....

1960-E

Ki.