


# T. 9 S.R. 4W.W.M.

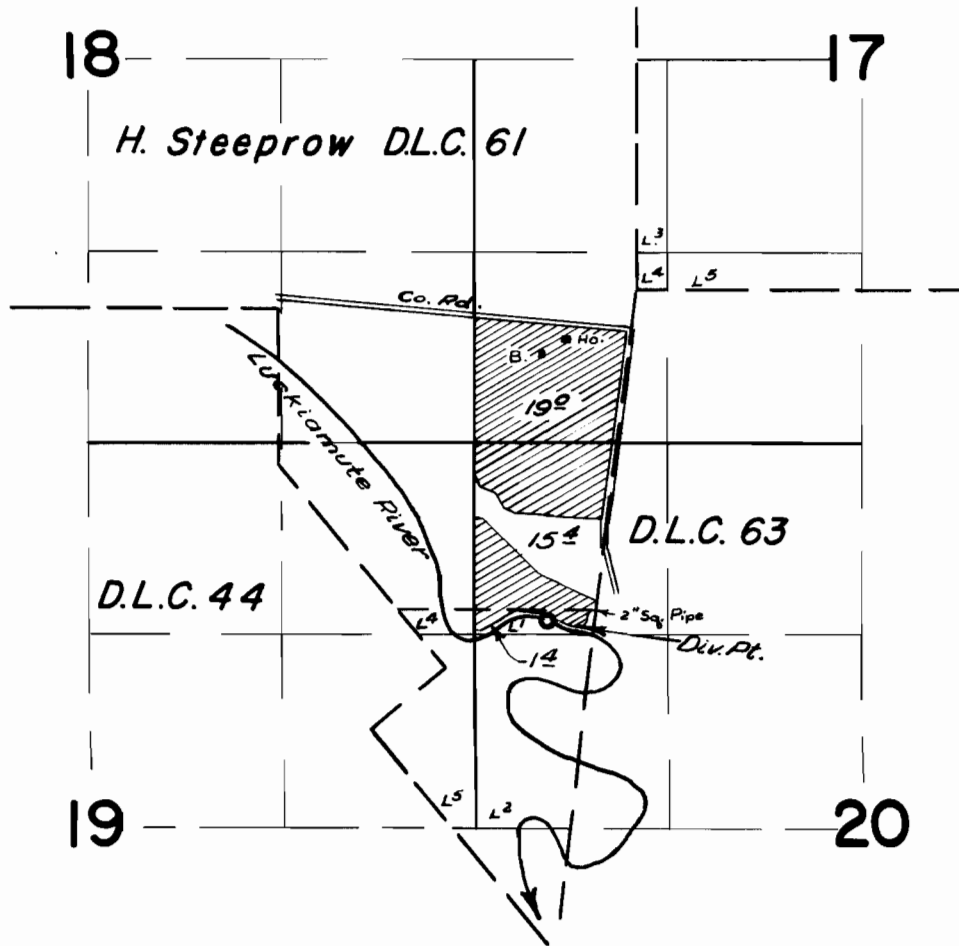

## FINAL PROOF SURVEY UNDER

Application No. 29652 Permit No. 23351  
IN NAME OF

WESLEY THOMAS

Surveyed 7 Sept. 1960, by Mr. B. B. Baker