


T.8S.R.5&6W.W.M.

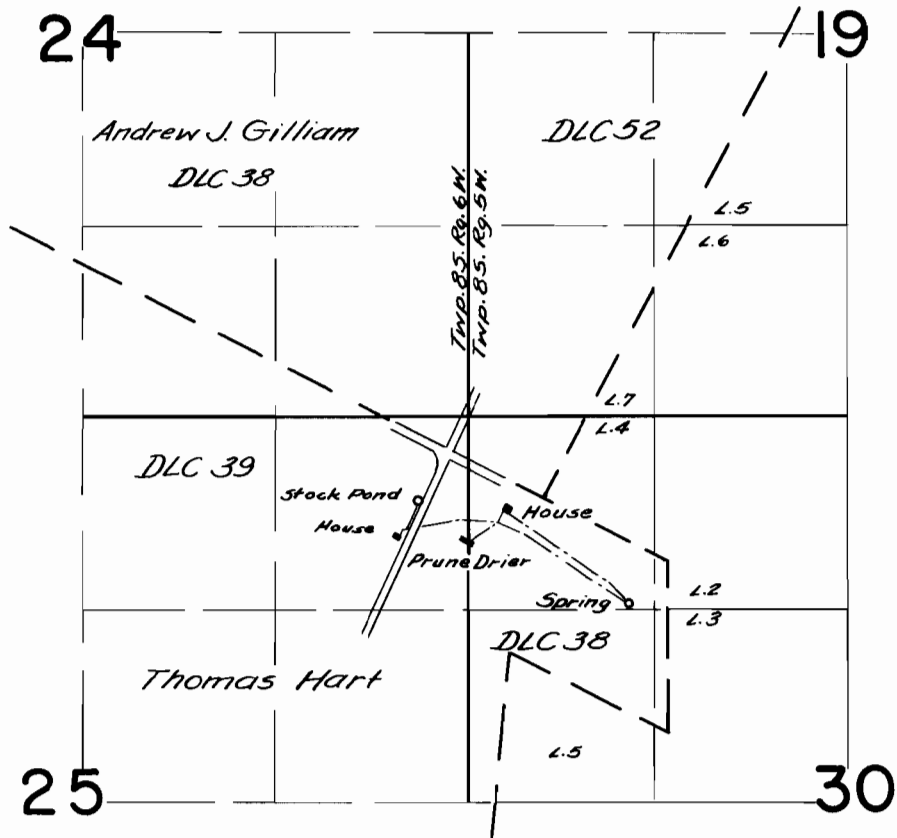

FINAL PROOF SURVEY UNDER

Application No. 30022 Permit No. 23639
IN NAME OF

FRANK P. WIENS

Surveyed Aug. 17, 1960, by C. O. Bartels