


# T.7S.R.5&6W.W.M.

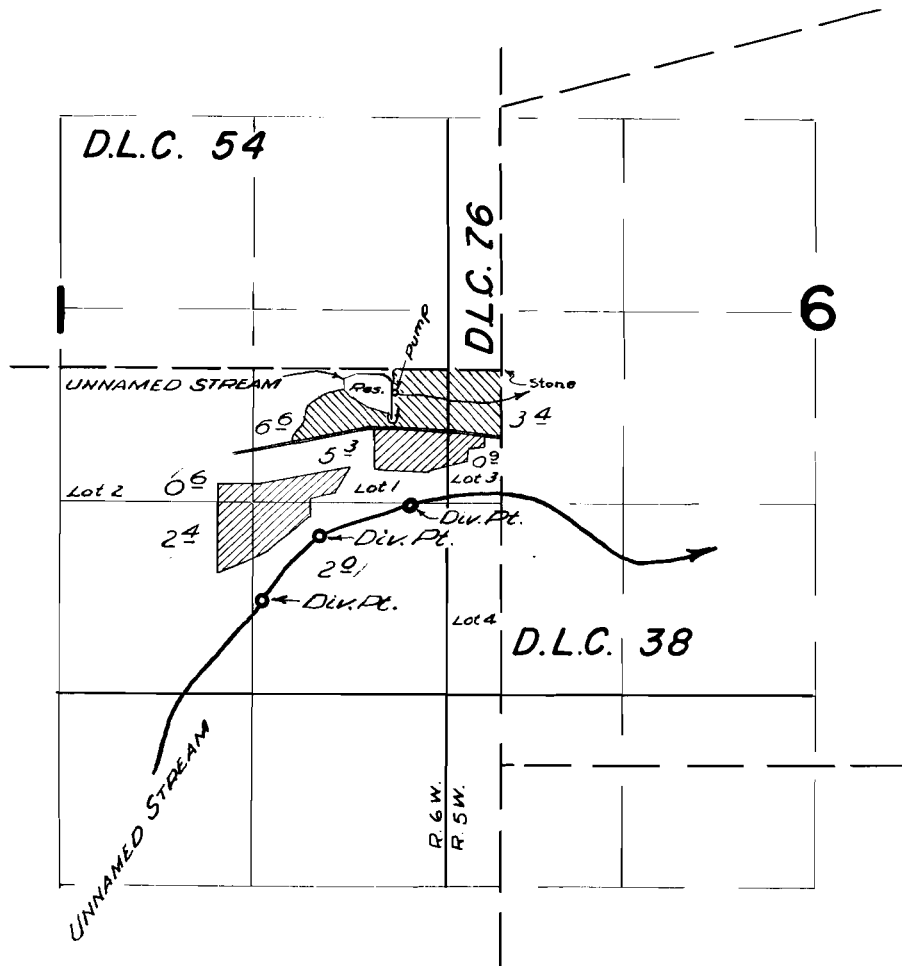

## FINAL PROOF SURVEY UNDER

R-32463                      R-2157  
 32464                      25634  
 Application No. 31275      Permit No. 24639

IN NAME OF

**JOHN AEBI**

Surveyed 8 Sept. 1960, by *M. Bish*