


T.7S.R.5&6W.W.M.

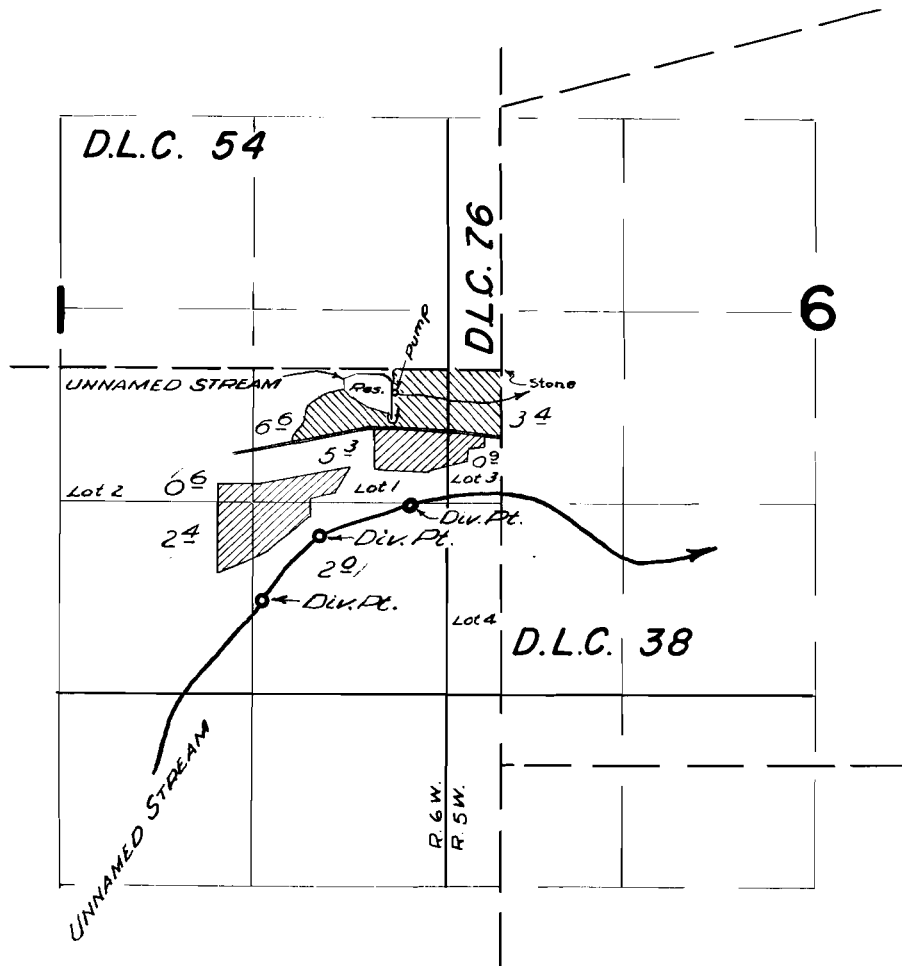

FINAL PROOF SURVEY UNDER

R-32463 R-2157
 32464 25634
 Application No. 31275 Permit No. 24639

IN NAME OF

JOHN AEBI

Surveyed 8 Sept. 1960, by *M. Bish*