


6-398  
28479

# T. 1S. R. 32E. W.M.

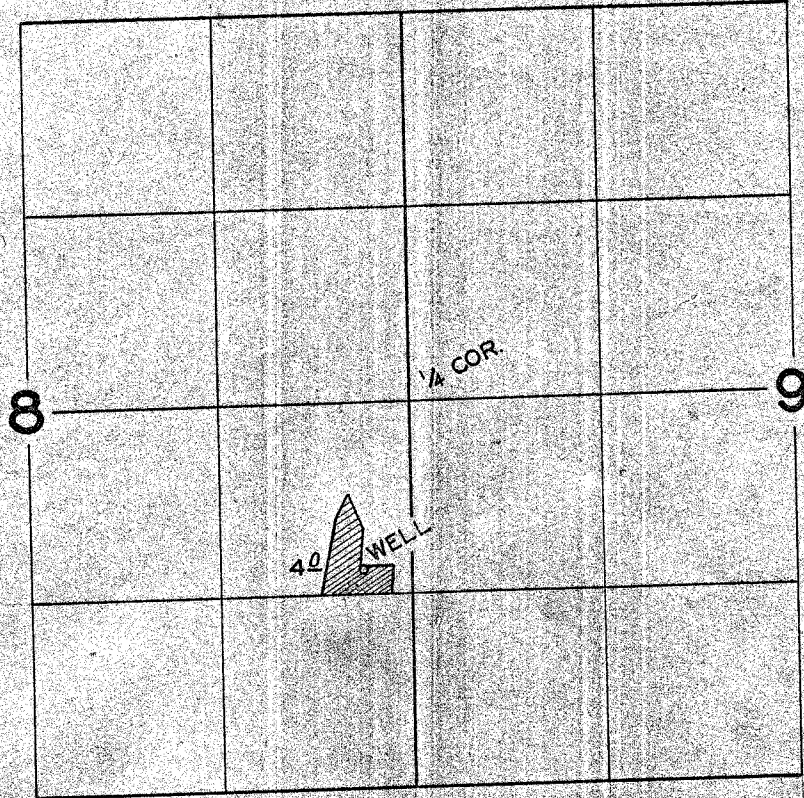

## FINAL PROOF SURVEY UNDER

Application No. G 499 Permit No. G 398  
IN NAME OF

GLEN NEWQUIST

Surveyed JULY 13 1960, by [Signature]