


T. 2N. R. 34E. W.M.

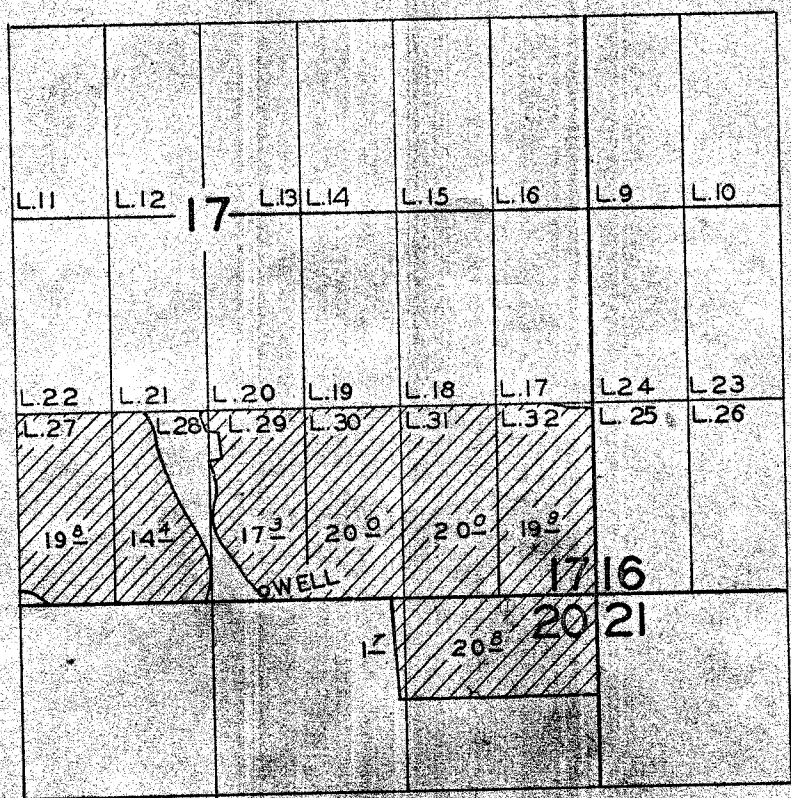

FINAL PROOF SURVEY UNDER

Application No. G.774 Permit No. G.675
IN NAME OF

RICHARD A. FOWLER

Surveyed JULY 2019.60. by [Signature]