


T.6N.R. 35E.W.M.

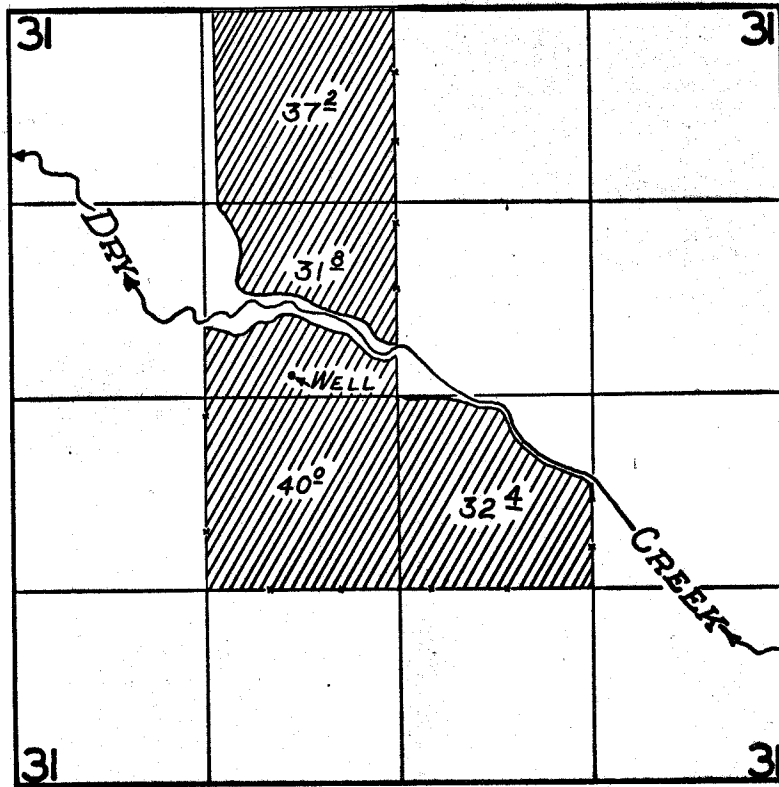

FINAL PROOF SURVEY UNDER

Application No. G-1116..... Permit No. G-954.....
IN NAME OF

.....CLARK KEY.....

Surveyed JULY 14 1960, by M. BISH.....