


T6N.R.35E.W.M.

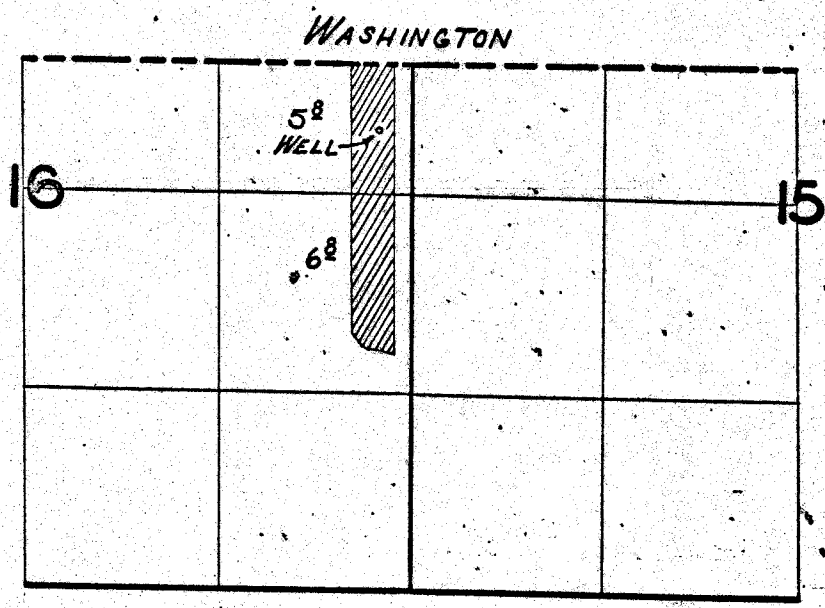

FINAL PROOF SURVEY UNDER

Application No. G.1159 Permit No. G.991.....
IN NAME OF

DARRELL K. KEY

Surveyed JULY 15 1960, by M. BISH.....