


# T. 2 N. R. 30 & 31 E. W. M.

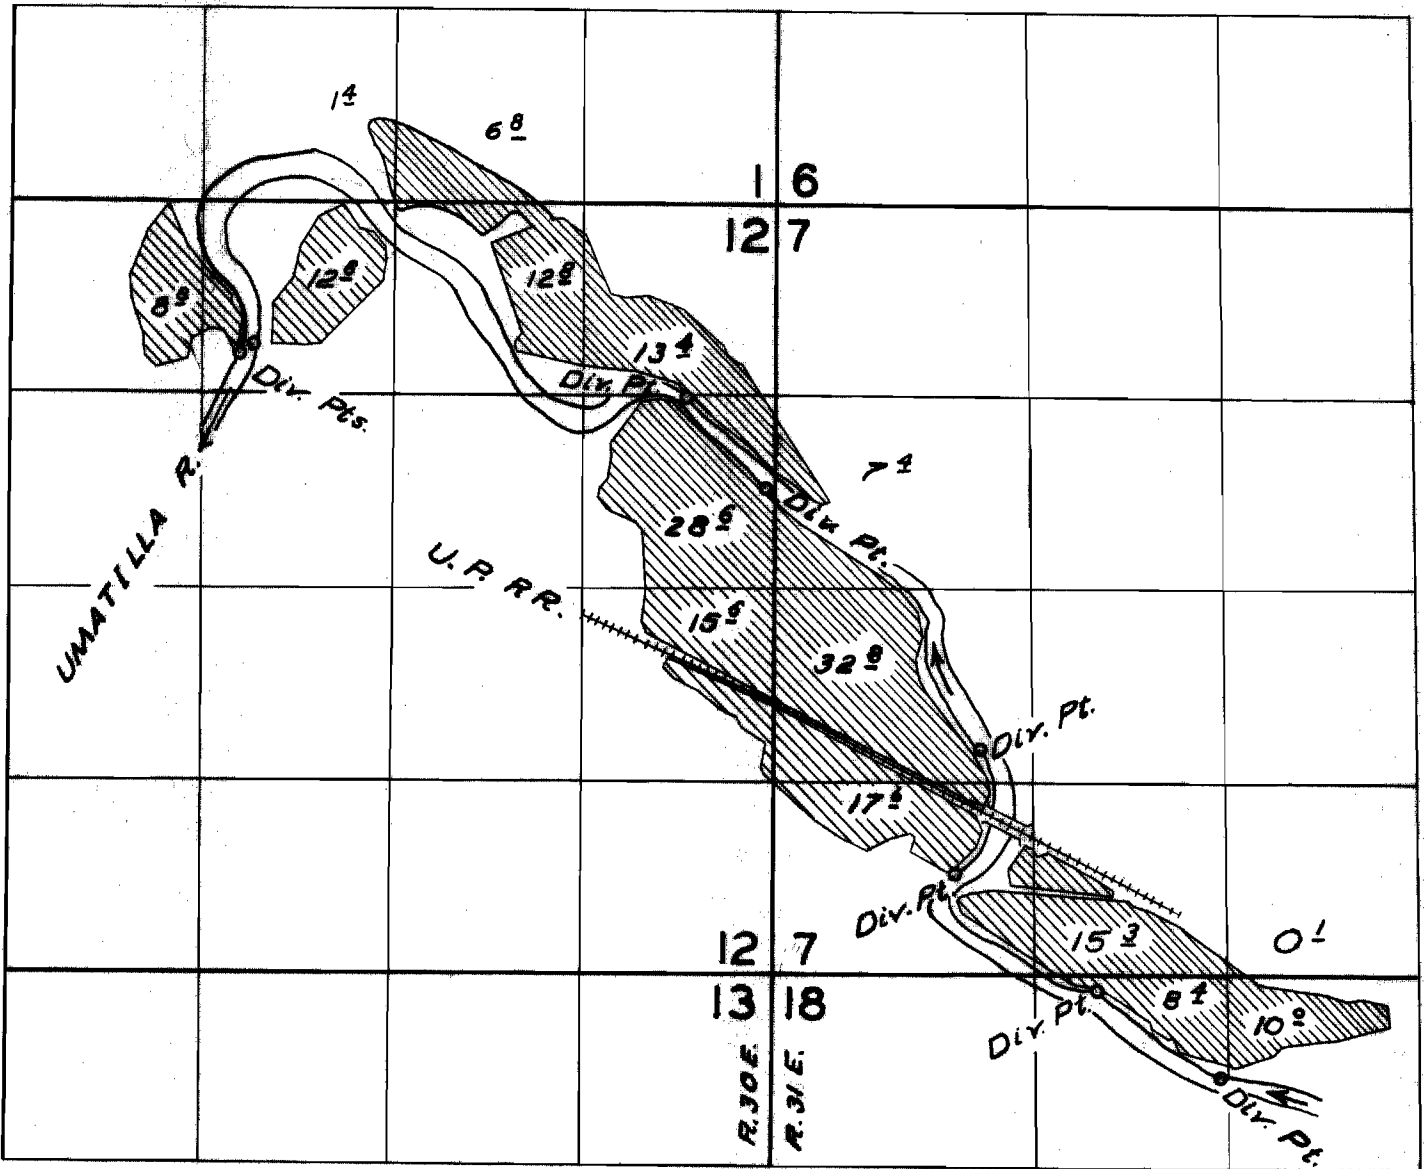

## FINAL PROOF SURVEY UNDER

Application No. 20,236 Permit No. 16,393  
IN NAME OF

*E. E. Burlingham & Sons*

Surveyed May 30, 1958, by C. O. Bartels  
July 16, 1960, by R. H. Jackson