


T. 1N. R. 31E. W.M.

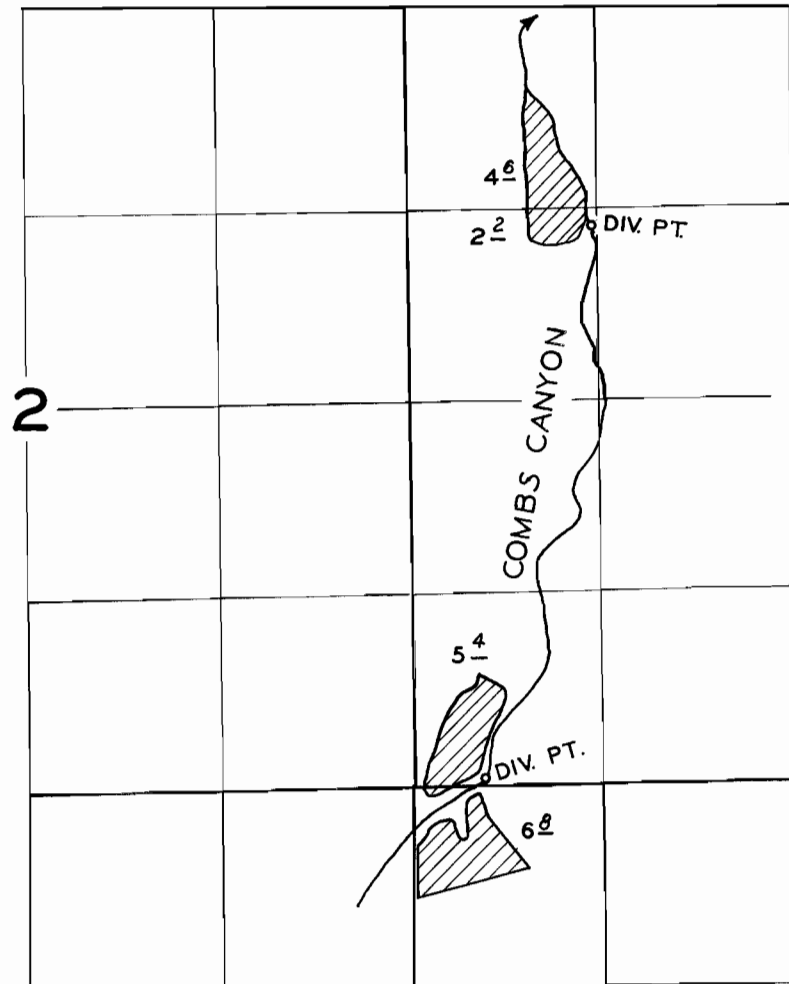

FINAL PROOF SURVEY
UNDER

Application No. 28345 Permit No. 24060
IN NAME OF

LEROY & E.A. BEILKE

Surveyed JULY 18 1960, by *L. Jackson*