


T. 2N. R. 33E. W.M.

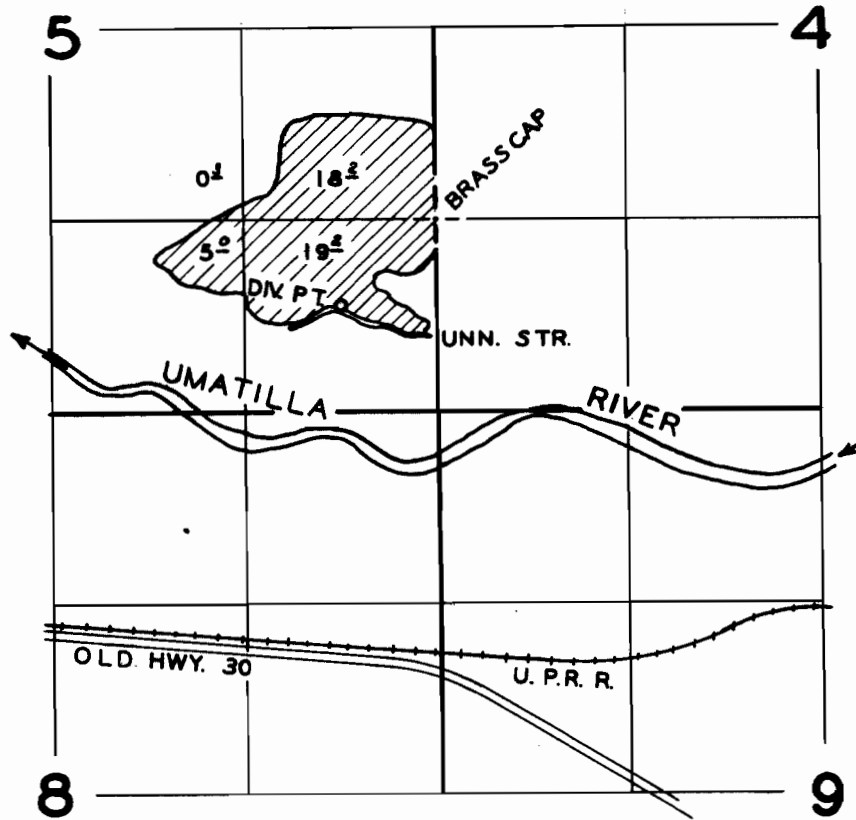

**FINAL PROOF SURVEY**  
UNDER

Application No. 31224 Permit No. 24610  
IN NAME OF

**WILLIAM DUFF**

Surveyed JULY 14 19 60, by *[Signature]*