


T.2S.R.2W.W.M.

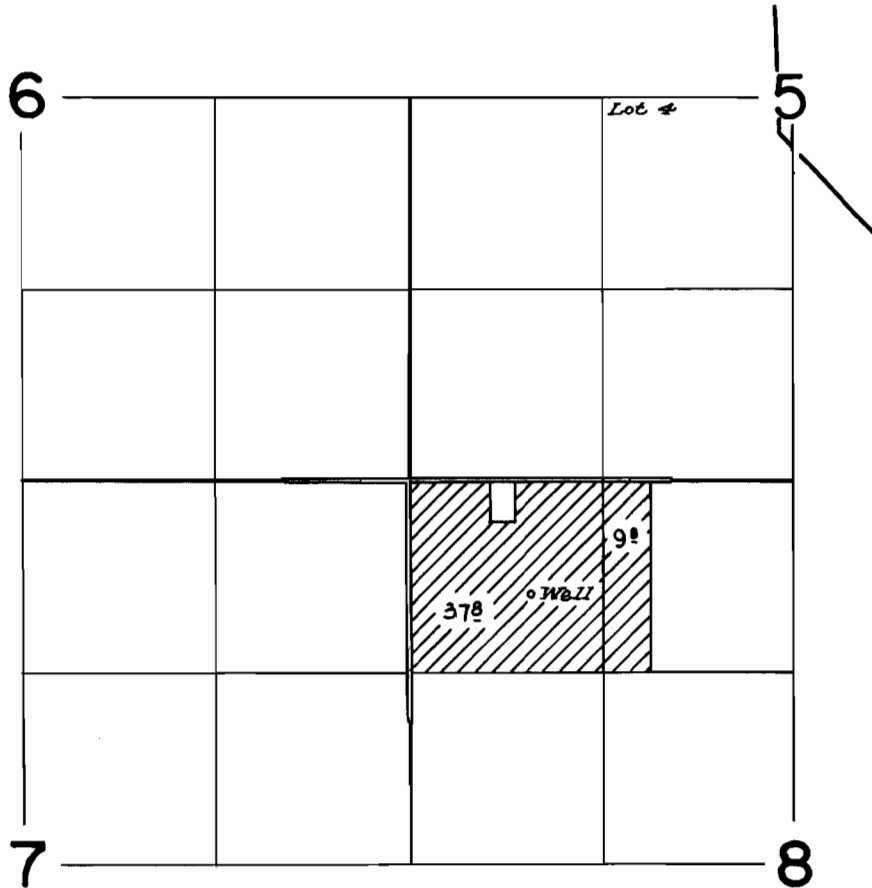

FINAL PROOF SURVEY
UNDER

Application No. G-201 Permit No. G-113
IN NAME OF

MELVIN J. FINEGAN

Surveyed June 1, 1900, by [Signature]