


# T.I.S. R. 3 W.W.M.

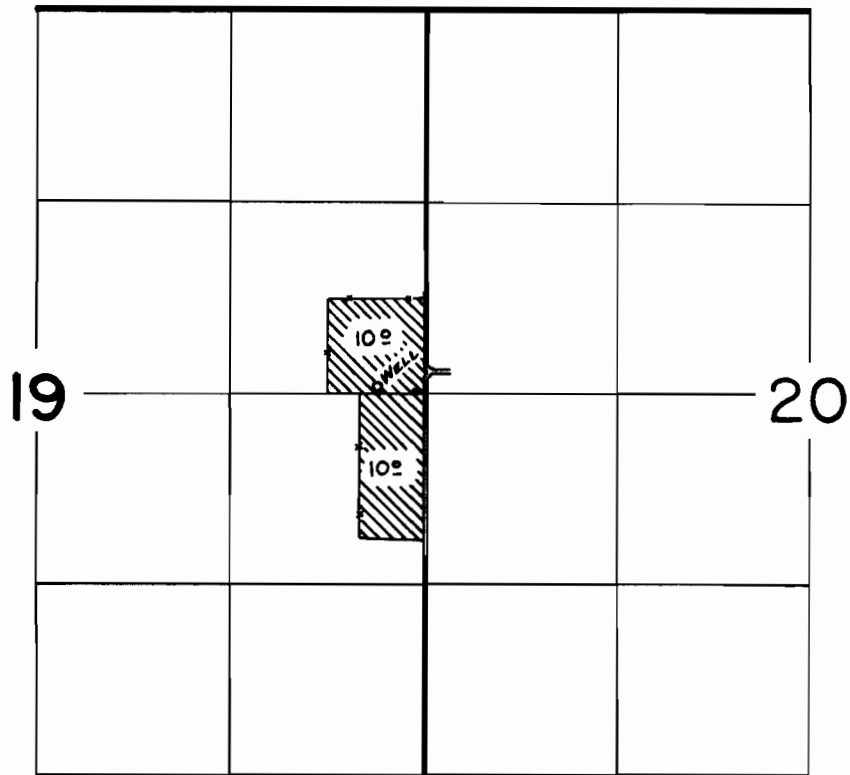

## FINAL PROOF SURVEY UNDER

Application No. G-792. Permit No. G-686  
IN NAME OF

P.L. & NANCY COOK

Surveyed June 23 1960, by

*[Signature]*