


T. 1 S. R. 2 W. W. M.

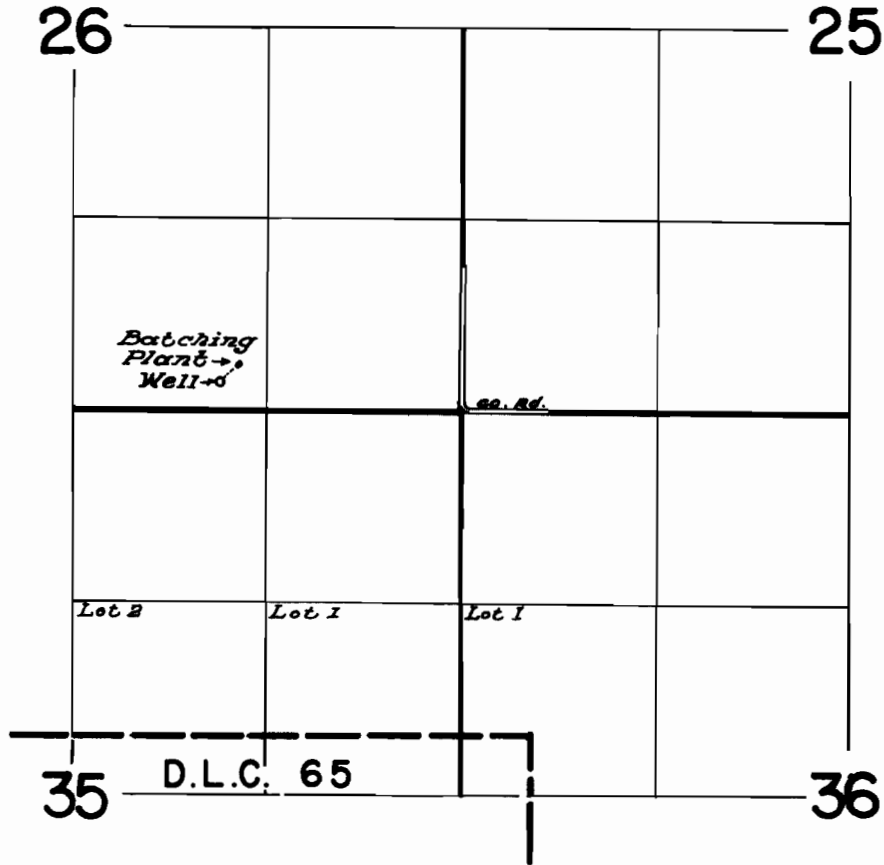

FINAL PROOF SURVEY
UNDER

Application No. G-1135 Permit No. G-965
IN NAME OF

WARREN-NORTHWEST INC.

Surveyed June 22 1960, by *D. H. Jackson*