


T.2S. R.2 W.W.M.

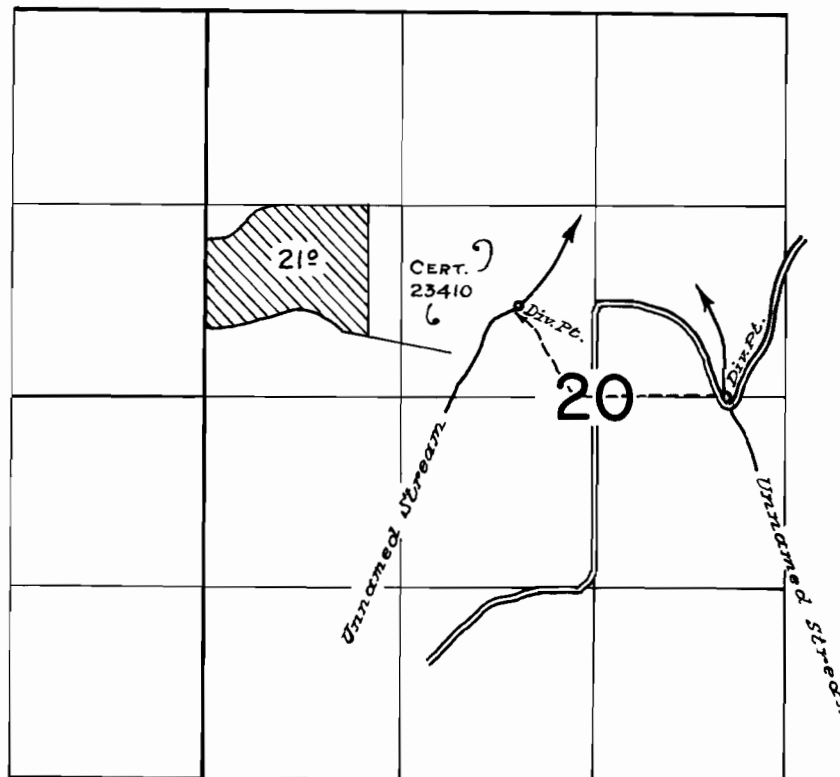

FINAL PROOF SURVEY
UNDER

Application No. 28998... Permit No. 22799...
IN NAME OF

KENNETH C. JAQUITH

Surveyed May 27, 1960, by [Signature]