


T.2S. R.2W.W.M.

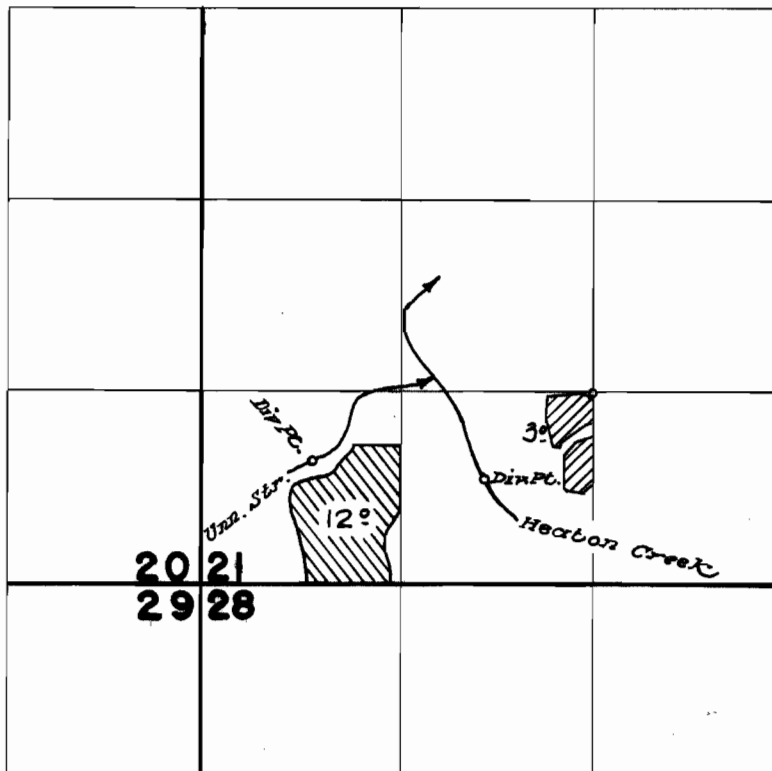

FINAL PROOF SURVEY
UNDER

Application No. 29254... Permit No. 23121.....
IN NAME OF

.....GLENN M. FIXSEN.....

Surveyed June 1, 1960, by *[Signature]*