


T.2 S. R. 1 W. W. M.

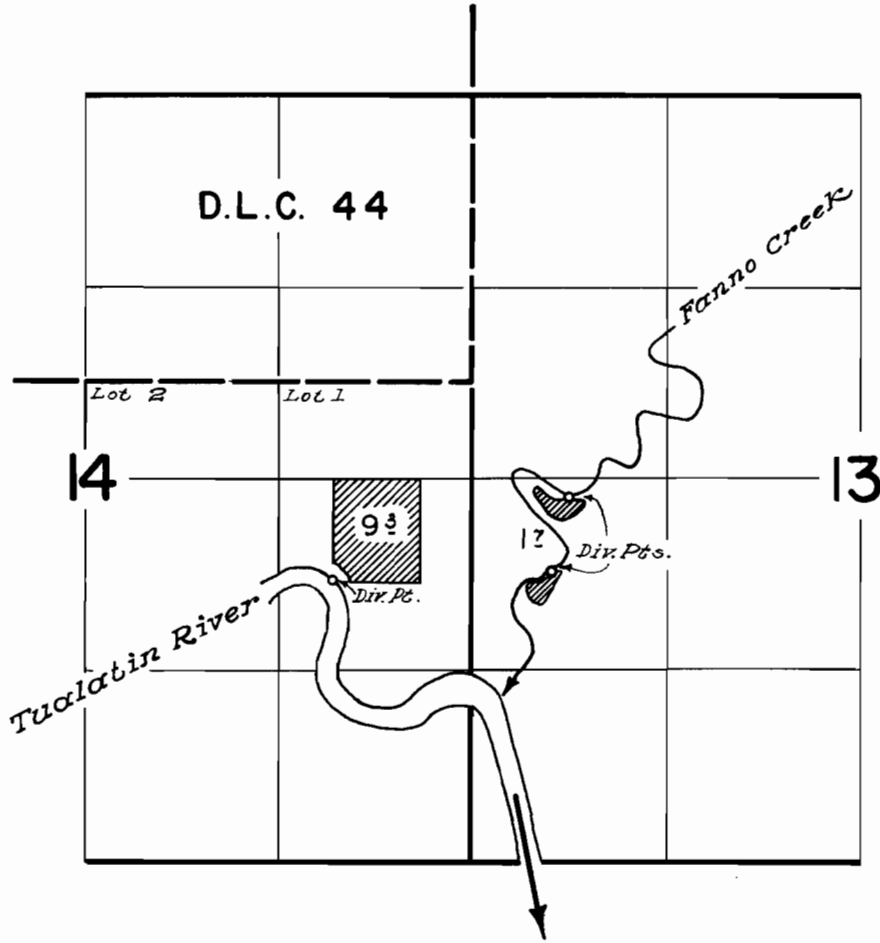

**FINAL PROOF SURVEY**  
UNDER

Application No. 30.11.7... Permit No. 23.7.7.1  
IN NAME OF

**HENRY S. MEARS**

Surveyed May 23, 1960, by *[Signature]*