


# T. IS. R. IW. W.M.

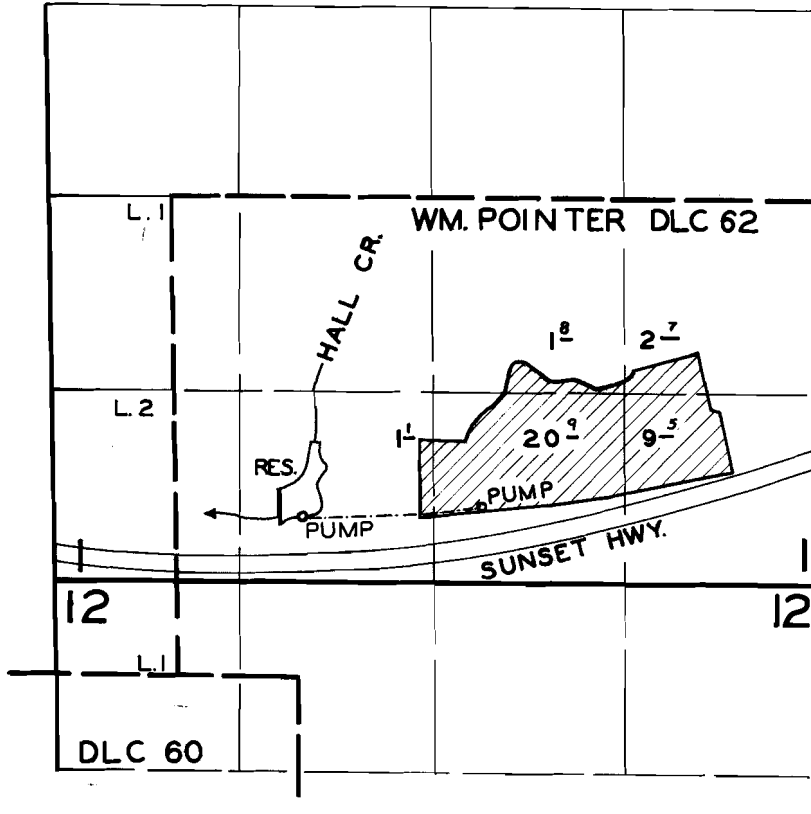

## FINAL PROOF SURVEY UNDER

Application No. R 27790 Permit No. R1807  
27791 23914  
IN NAME OF

WADE STROWGER

Surveyed JULY 6 1960, by C. O. BARTELS