


T. IS. R. IW. W.M.

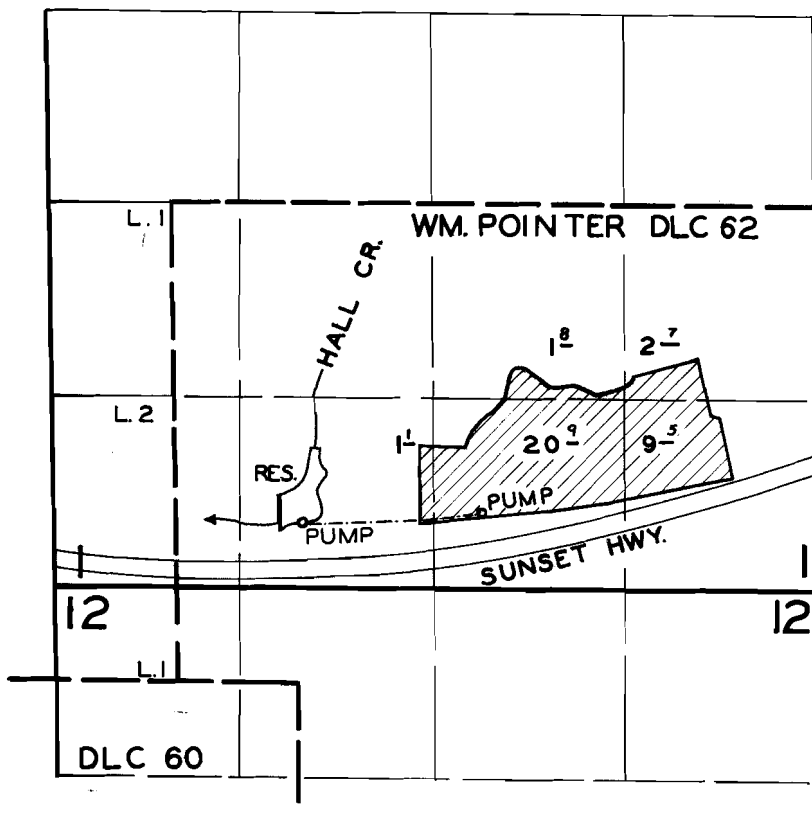

FINAL PROOF SURVEY UNDER

Application No. R27790 Permit No. R1807
27791 23914
IN NAME OF

WADE STROWGER

Surveyed JULY 6 1960, by C. O. BARTELS