


T. 1 S. R. 4 W. W. M.

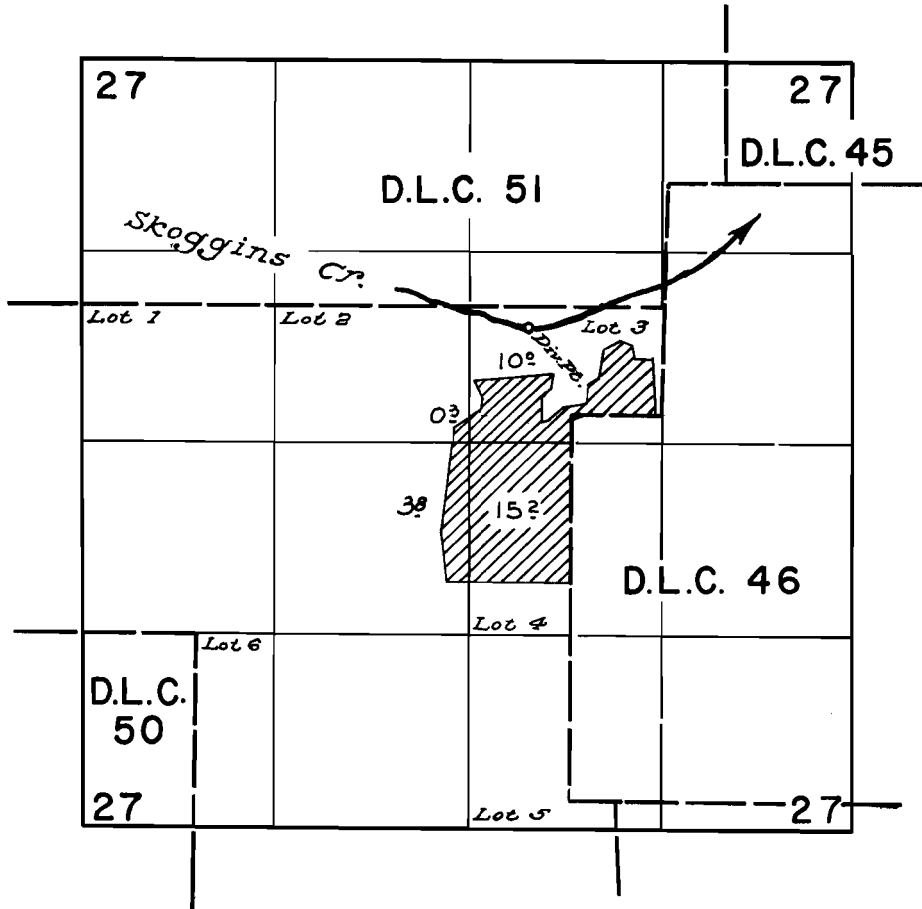

**FINAL PROOF SURVEY**  
UNDER

Application No. 30538 Permit No. 24045  
IN NAME OF

**HARRY FLUKE**

Surveyed June 2, 1960, by *[Signature]*