


T.1S. R.2 W.W.M.

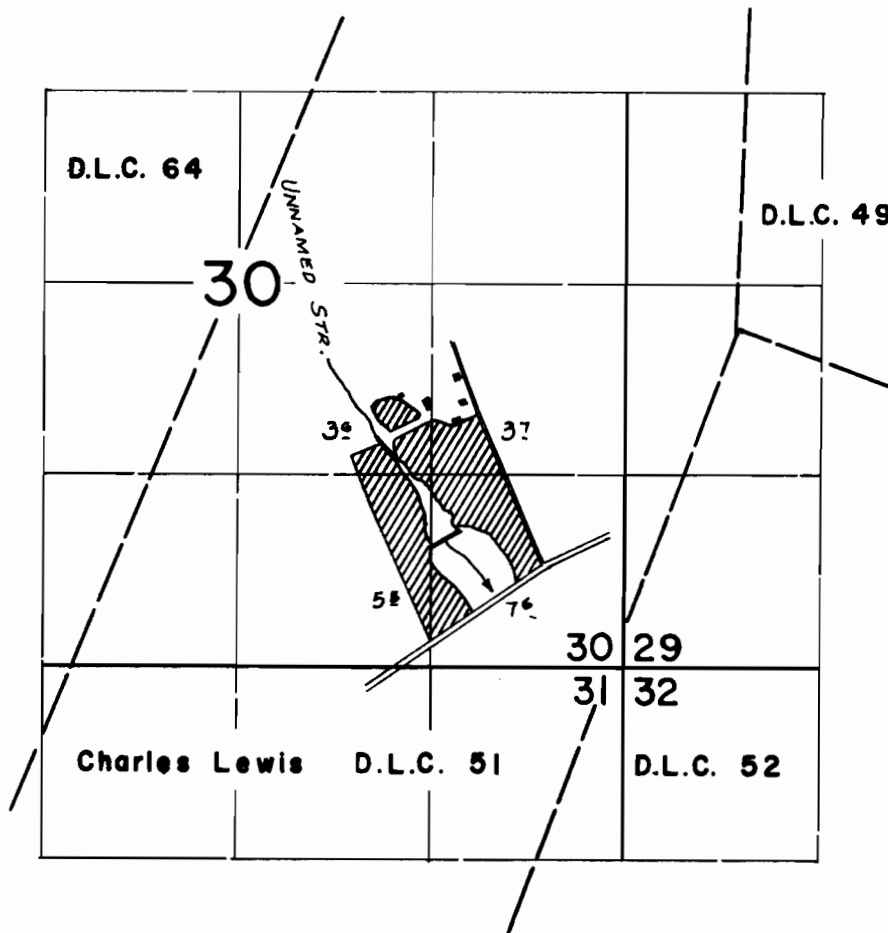

FINAL PROOF SURVEY UNDER

Application No. ^{R-28983} 28984 Permit No. ^{R-1833} 24061
IN NAME OF

Alvin Schulmerich

Surveyed June 22 1960, by *[Signature]*