


T.2S.R.1W.W.M.

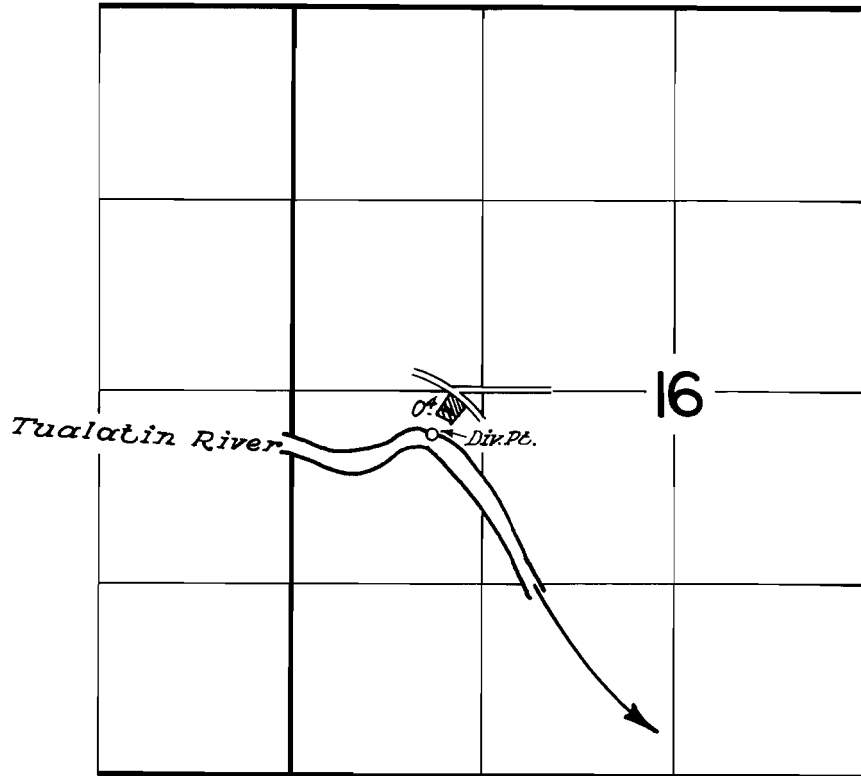

**FINAL PROOF SURVEY**  
UNDER

Application No. 30646 Permit No. 24142  
IN NAME OF

**Glenn U. & Virginia AnDyke**

Surveyed May 23 1960, by