


T. 1 S. R. 2 W. W. M.

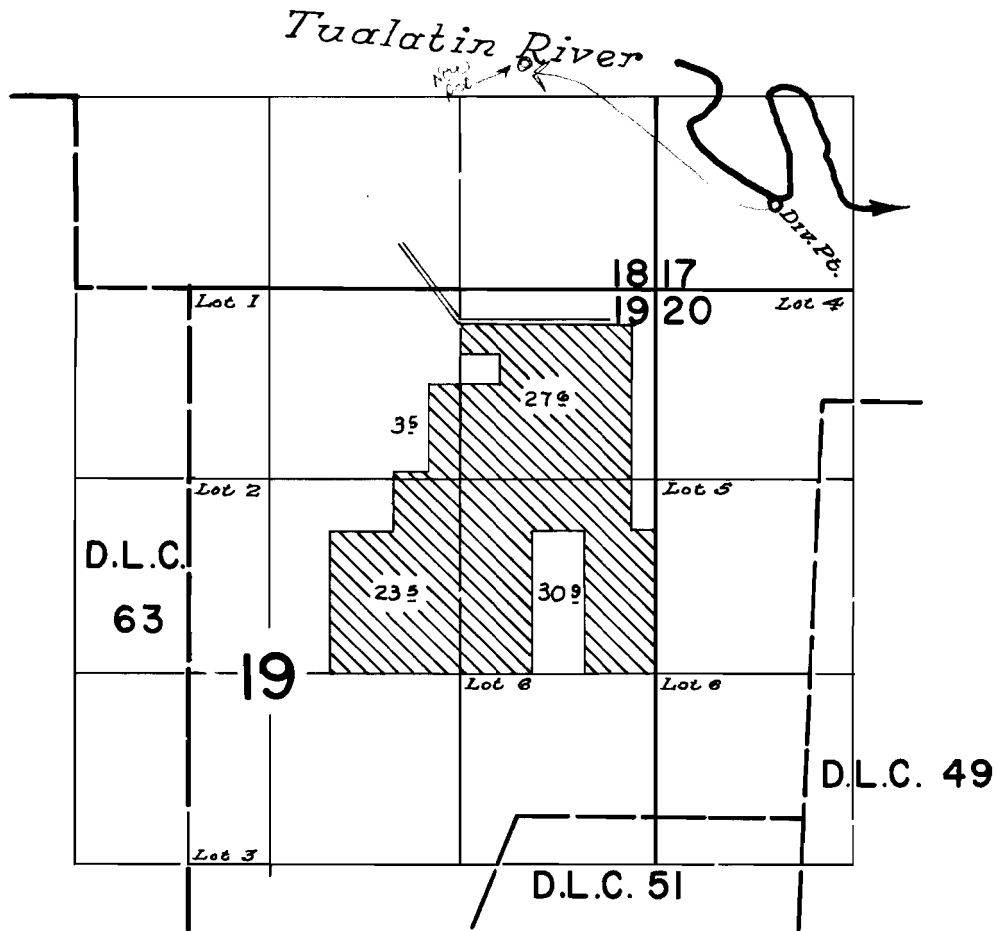

**FINAL PROOF SURVEY**  
UNDER

Application No. 30661... Permit No. 24174...  
IN NAME OF

**LOUIS HILLECKE**

Surveyed June 22 1960, by

*Johnson*