


T.1N.R.4W.W.M.

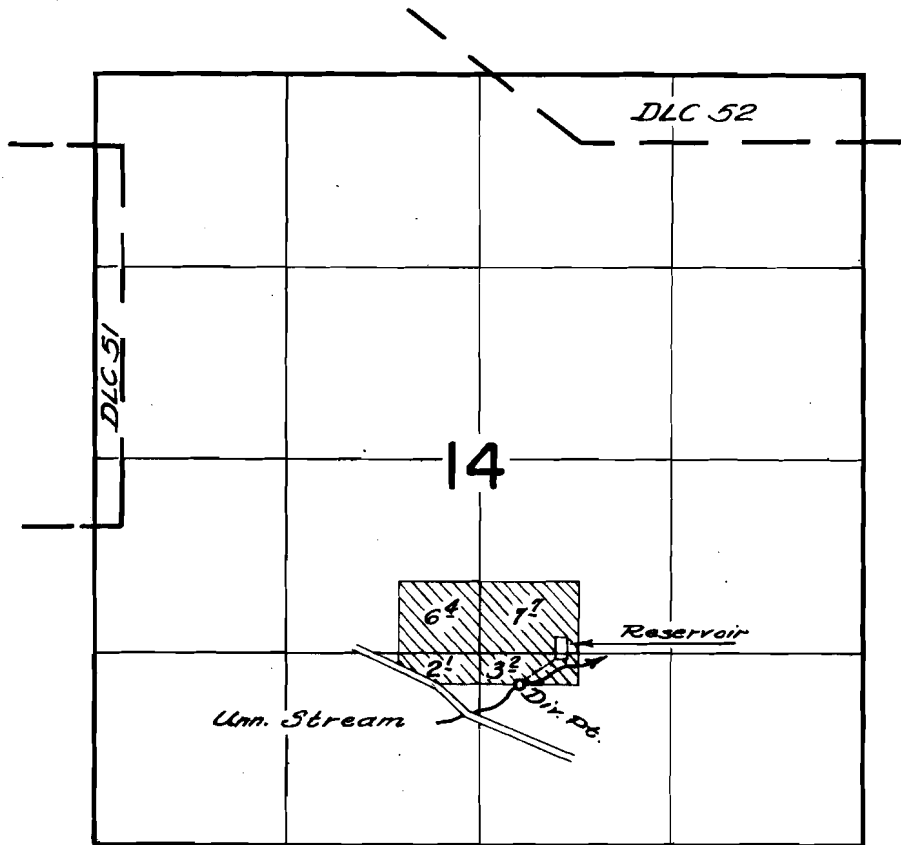

FINAL PROOF SURVEY
UNDER

Application No. *R-30727* ~~30728~~ Permit No. *R-1867* ~~24218~~
IN NAME OF

ERNEST F. Heesacker

Surveyed *August 2* 1960, by *R.H. Jackson*