


# T.2S. R.1W.W.M.

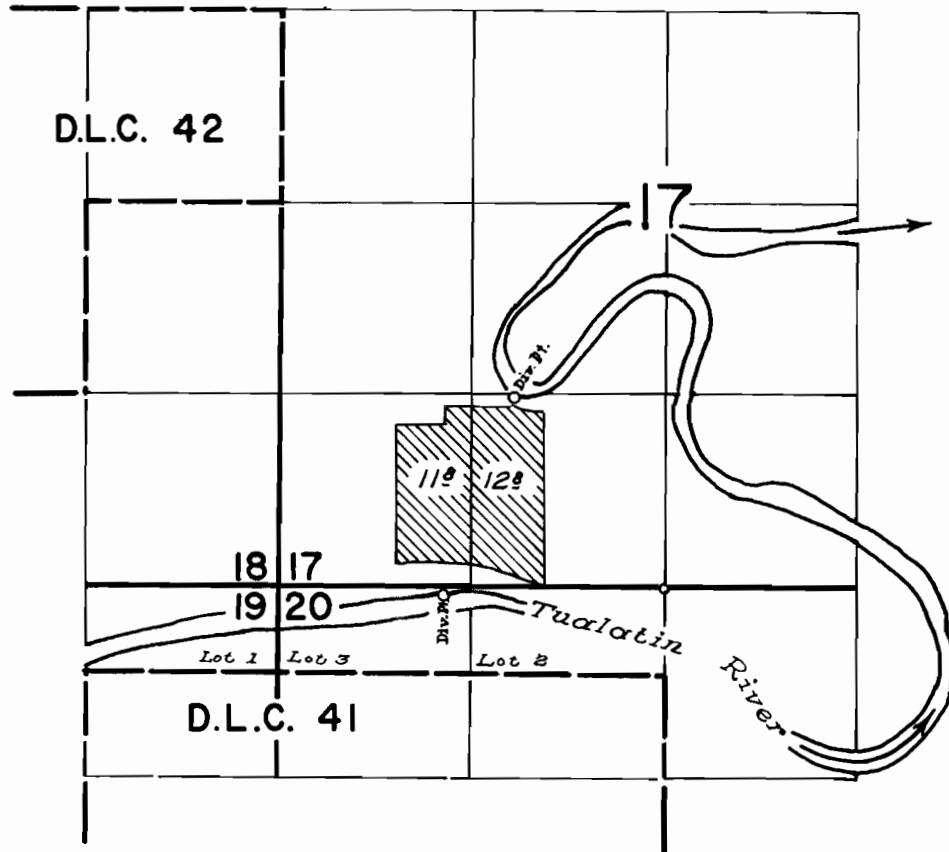

## FINAL PROOF SURVEY UNDER

Application No. 30869 Permit No. 24369  
IN NAME OF

**STEINHOFF HEIRS**

Surveyed May 23 1960, by *[Signature]*