


# T.2N. R.3 W.W.M.

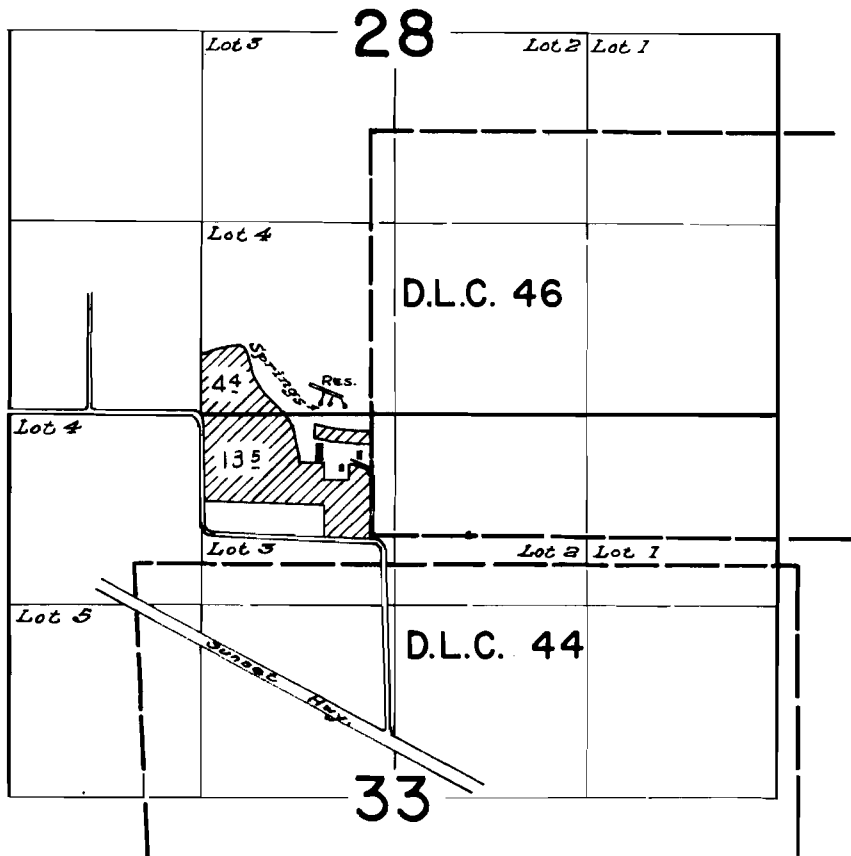

## FINAL PROOF SURVEY UNDER

Application No. <sup>R-31188</sup> 37069 Permit No. <sup>R-1940</sup> 24510  
IN NAME OF

**ARCHIE & HENRIETTA JESSE**

Surveyed *Sept. 7* 1960. by *Alpharson*