


T.2N.R.38&4W.W.M.

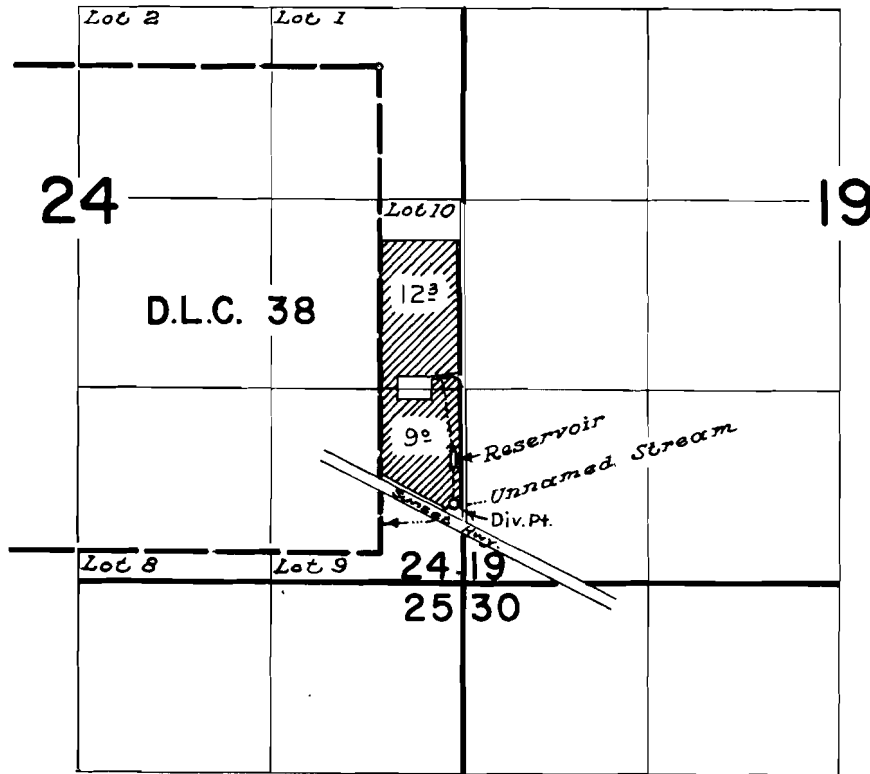

FINAL PROOF SURVEY
UNDER

Application No. ^{R-31261} 31262 Permit No. ^{R-1973} 24630
IN NAME OF

EDWARD GILBERT

Surveyed August 3 1960. by *Chickson*