# T.2 N. R.3&4 W.W.M.

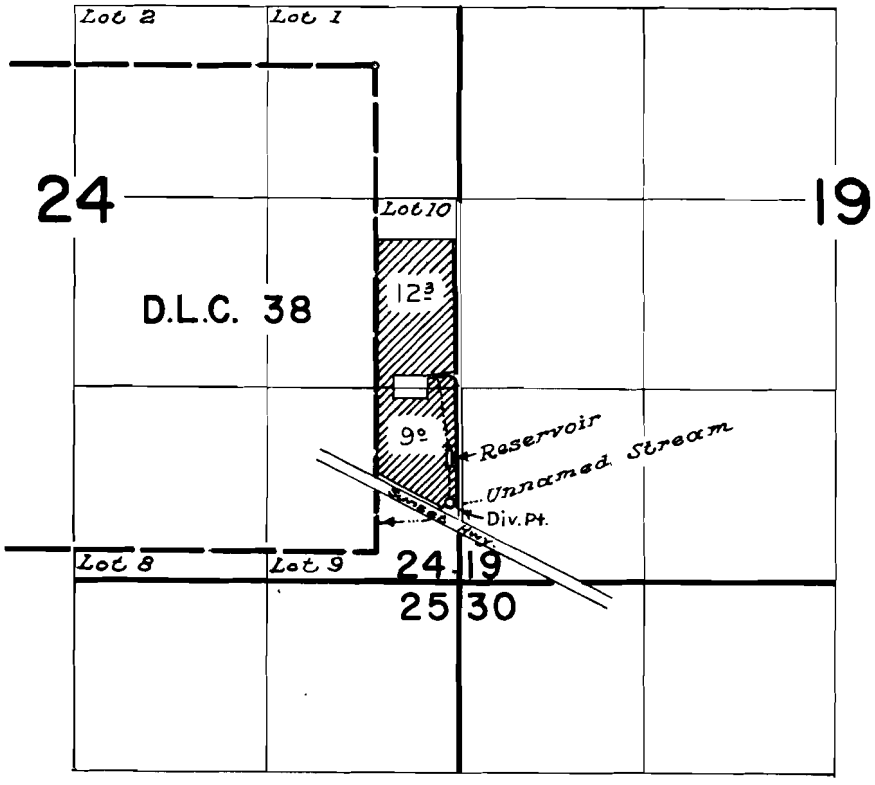


## FINAL PROOF SURVEY

UNDER

Application No. R-31261 31262 Permit No. R-1973 24630

IN NAME OF

**EDWARD GILBERT**

Surveyed *August 3* 1960, by *R. Jackson*

DFR-30-190