


T. 1 N. R. 4 W. W. M.

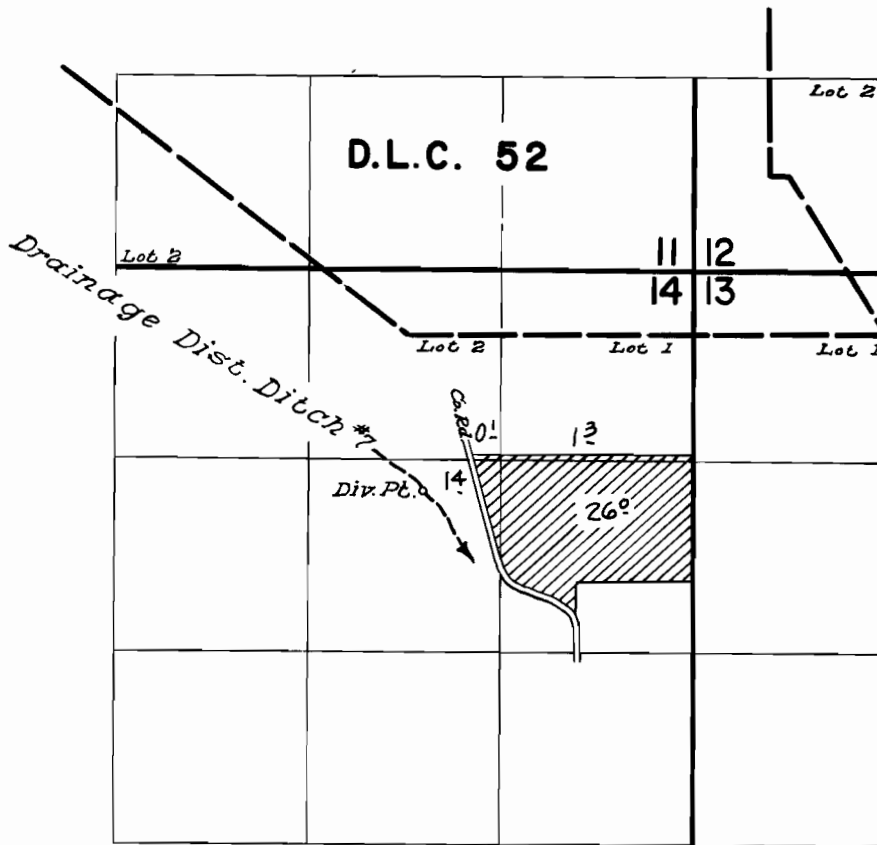

FINAL PROOF SURVEY UNDER

Application No. 31460 Permit No. 24773
IN NAME OF

Melvin L. & Viola E. Love

Surveyed Aug. 2 1960, by

Shelton