


T. 1 S. R. 2 W. W. M.

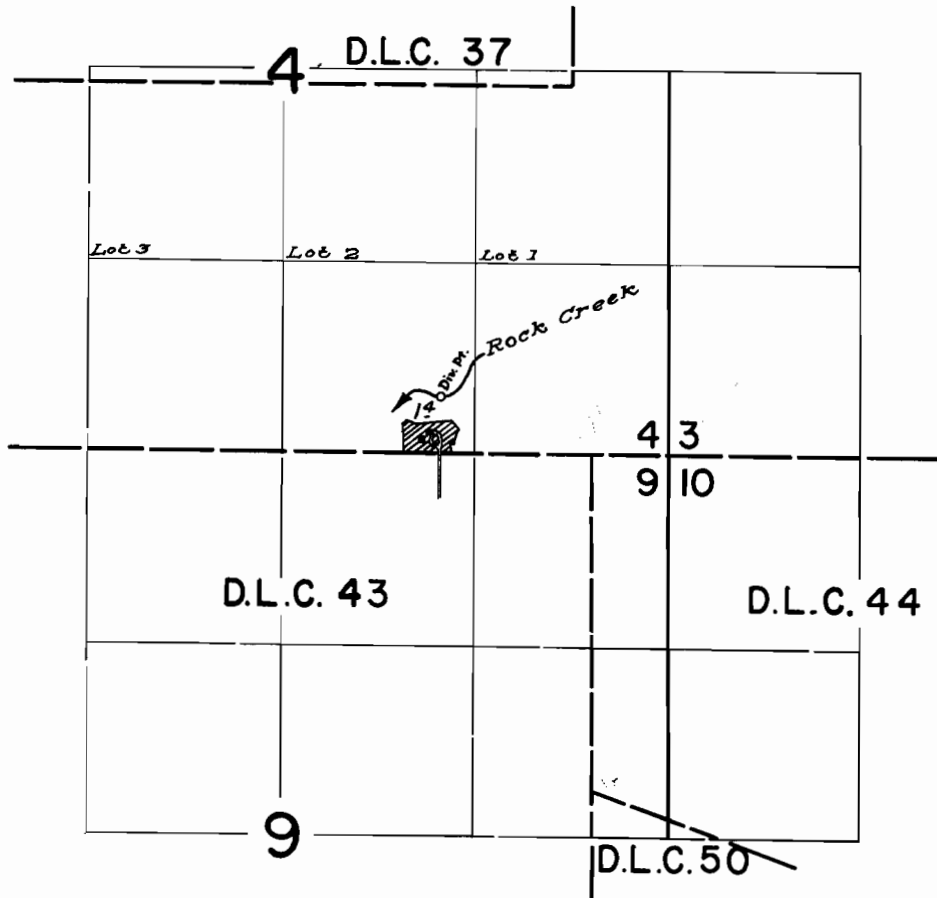

FINAL PROOF SURVEY UNDER

Application No. 32385 Permit No. 25574
IN NAME OF

SYVER O. RUUD

Surveyed July 6 1960, by

A. Jackson