


T. 2 N. R. 4 W. W. M.

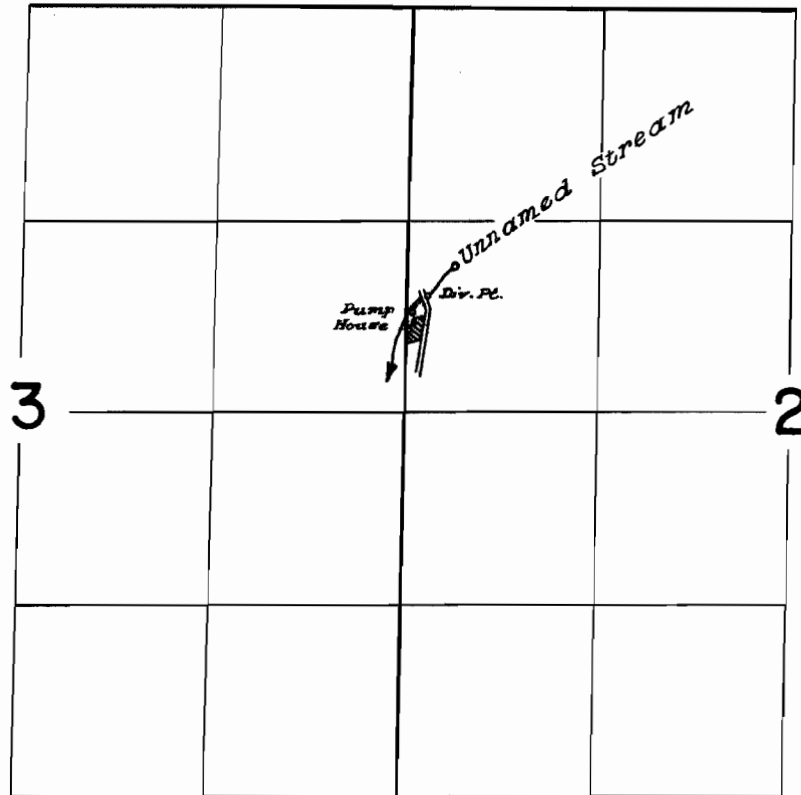

FINAL PROOF SURVEY
UNDER

Application No. 33741... Permit No. 26680..
IN NAME OF

..... Wesley E. Duncan

Surveyed August... 1960, by *W. E. Jackson*