


T.4 S.R.3 W.W.M.

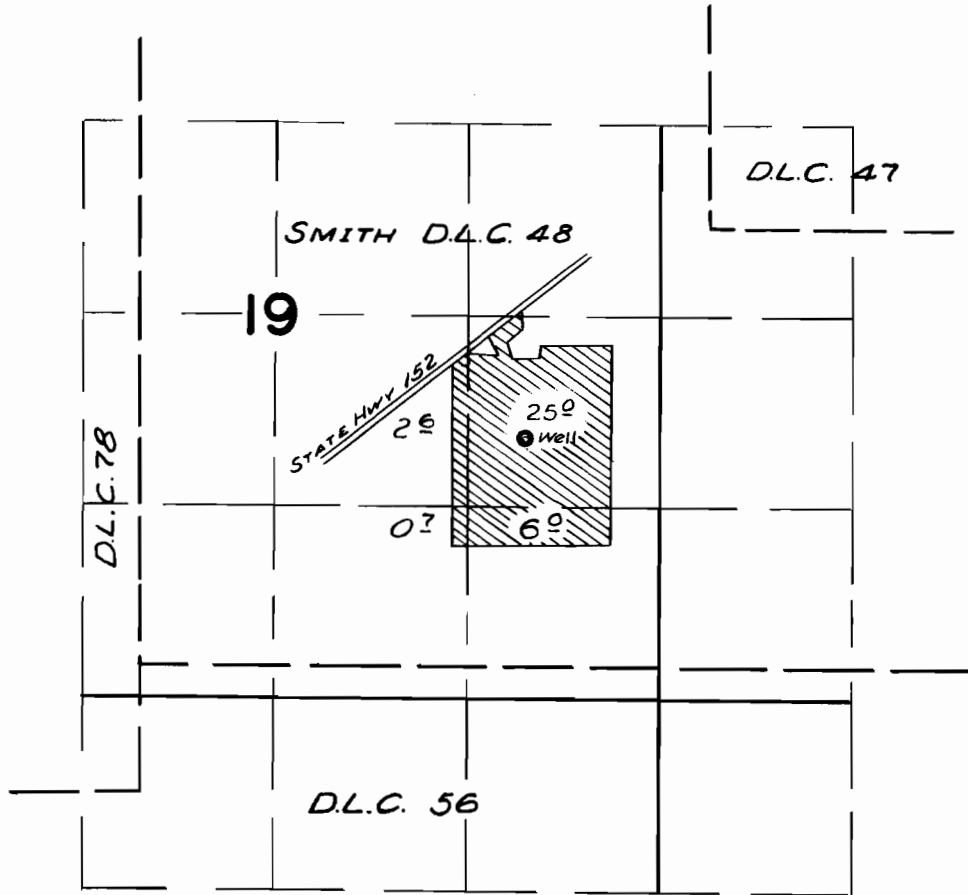

**FINAL PROOF SURVEY**  
UNDER

Application No. G-271 Permit No. G-174  
IN NAME OF

ROY ALTIMUS

Surveyed 25 MAY 1960 by M. Bish